
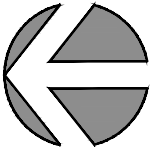


Suite #	Occupant Area	Rentable Area
Suite 101	3,221.55	3,378.50

Area Analysis performed in accordance with ANSI/BOMA Z65.1 - 2017 Method A Standard.

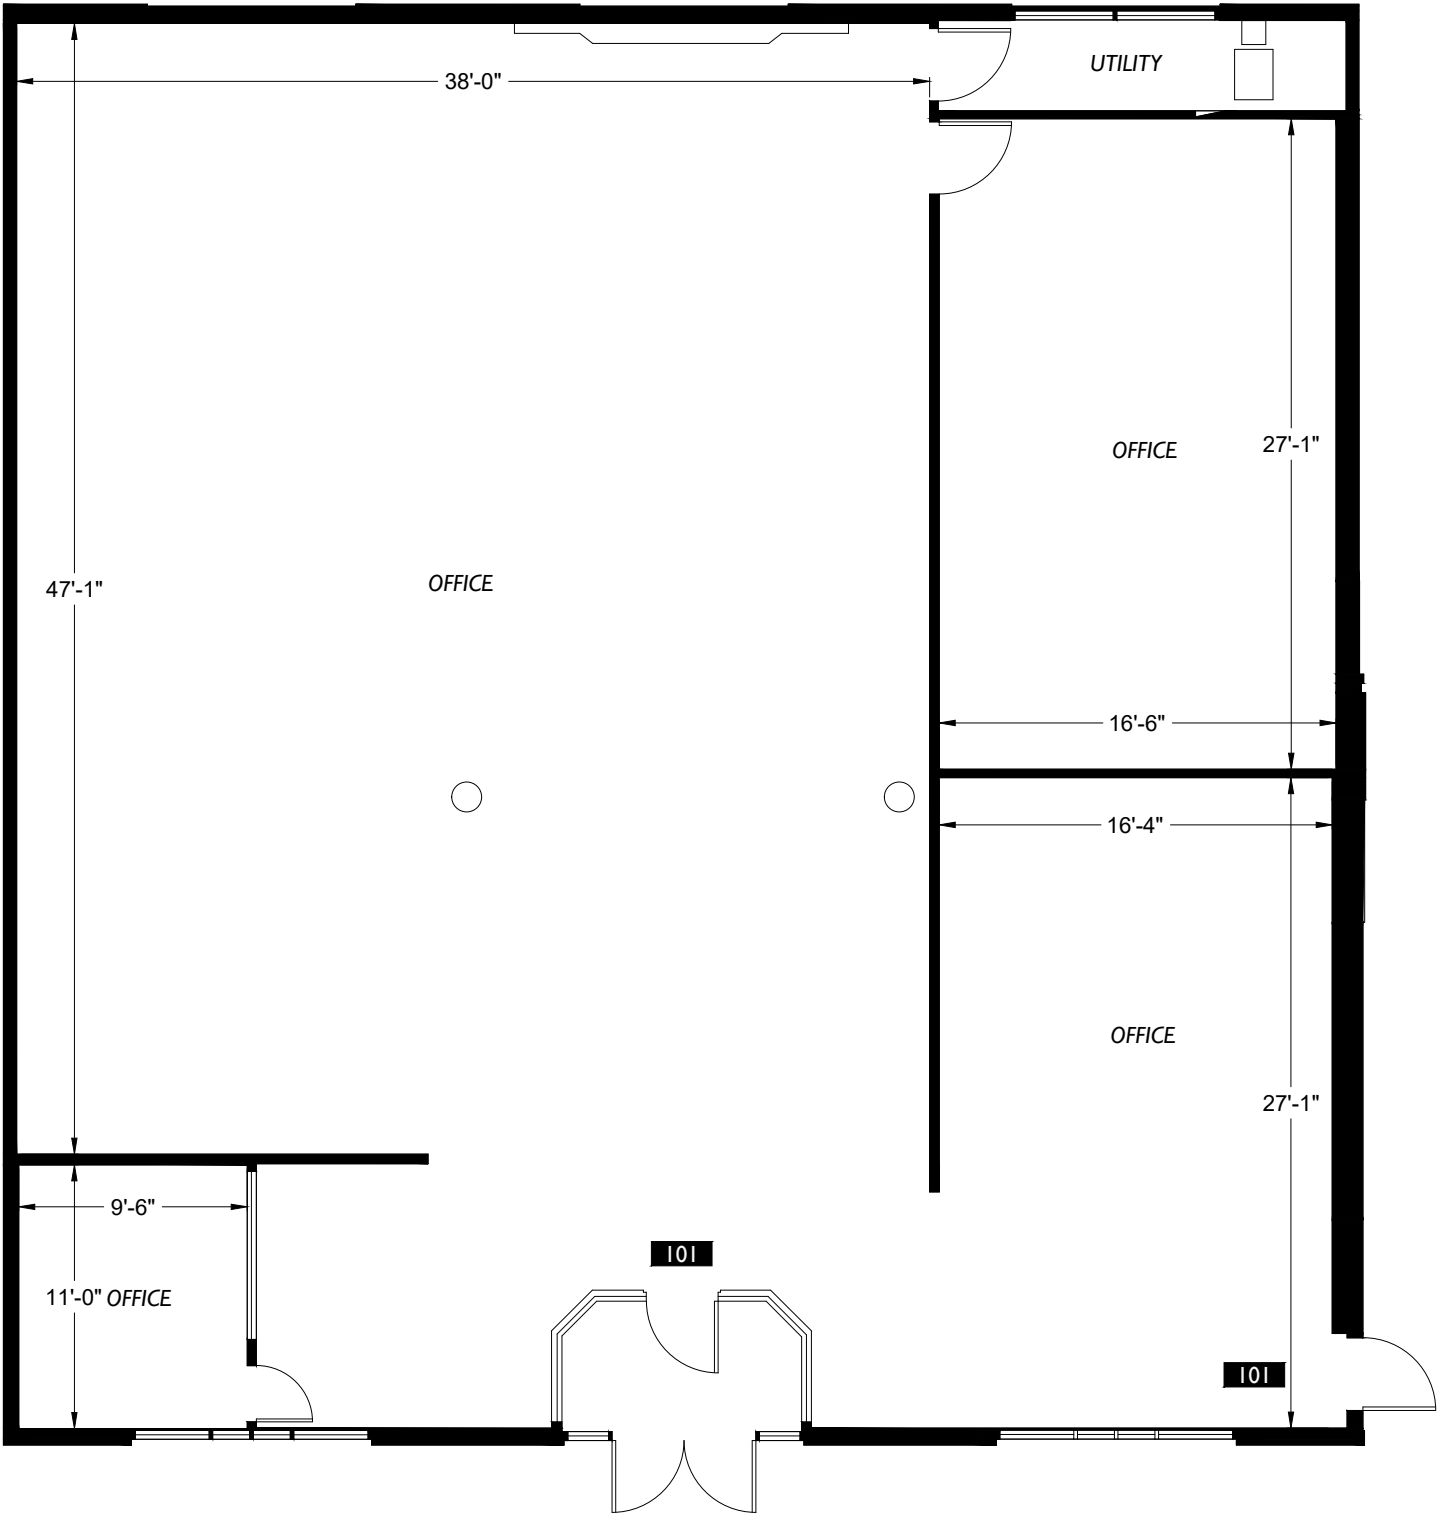

MarKoa Commercial Real Estate	Jade Plaza 8811 S Tacoma Way Lakewood, WA 98499	Suite 101	Scale 0 5 10	Measured: May 2020	Project: C20-412

2DFLOORPLANS.COM
425-677-7511
2-D
AS-BUILT
FLOOR PLANS

600 NW Gilman Blvd. Suite E
Issaquah, WA 98027