
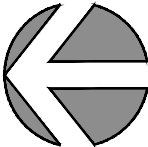


| Suite #   | Occupant Area | Rentable Area |
|-----------|---------------|---------------|
| Suite 207 | 382.24        | 441.29        |

Area Analysis performed in accordance with ANSI/BOMA Z65.1 - 2017 Method A Standard.

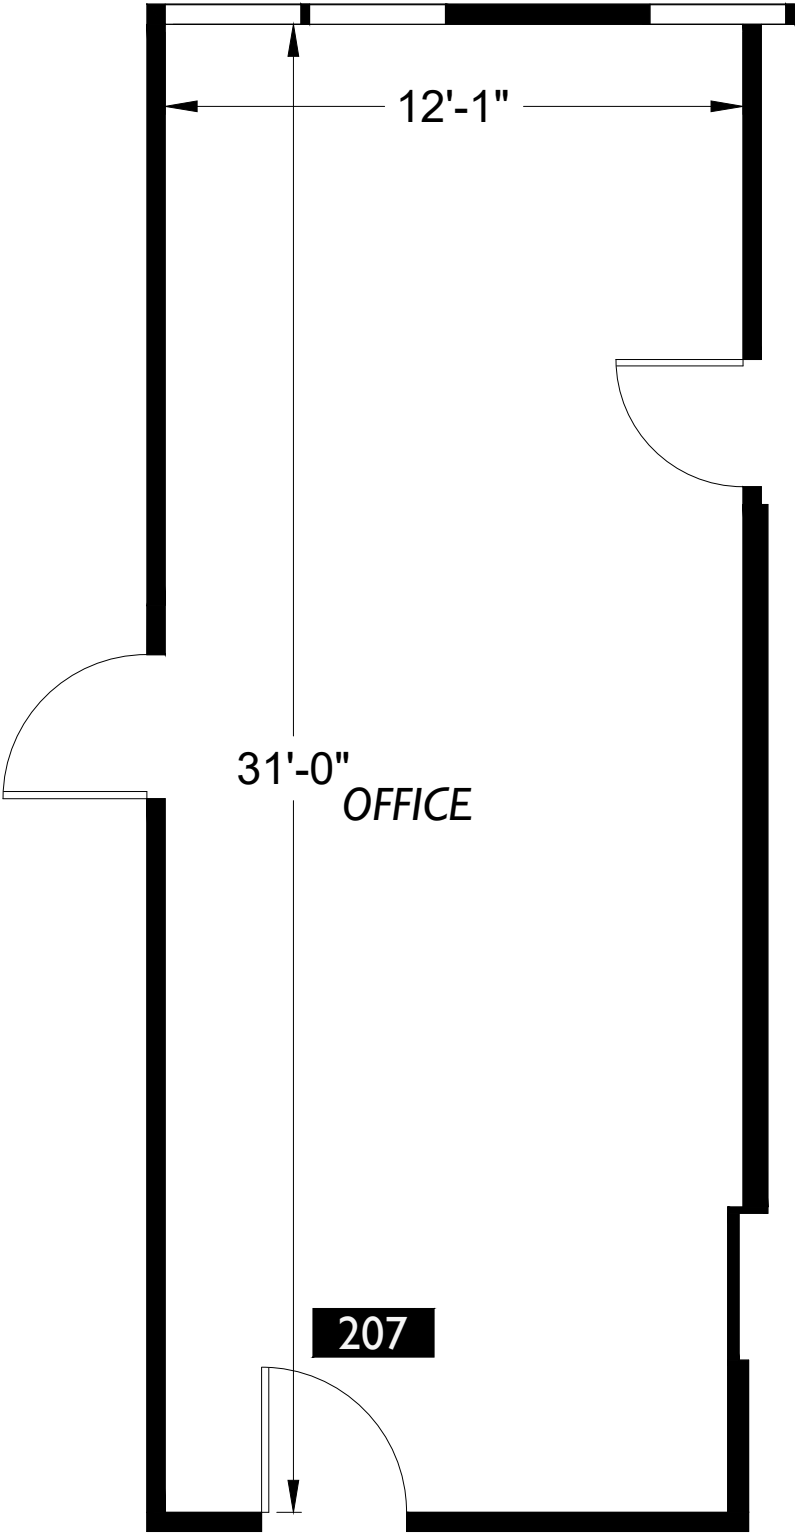

|                               |                                                       |                             |           |                                                                                                                                                      |                  |
|-------------------------------|-------------------------------------------------------|-----------------------------|-----------|------------------------------------------------------------------------------------------------------------------------------------------------------|------------------|
| MarKoa Commercial Real Estate | Jade Plaza<br>8811 S Tacoma Way<br>Lakewood, WA 98499 | Suite<br><b>207</b><br>Plan | <br>Scale | 2DFLOORPLANS.COM<br>425-677-7511<br><b>2-D</b><br>AS-BUILT<br>FLOOR PLANS<br>600 NW Gilman Blvd. Suite E<br>Issaquah, WA 98027<br>Measured: May 2020 | Project: C20-412 |
|                               |                                                       |                             |           |                                                                                                                                                      |                  |