


1101 MADISON

FIRST HILL

MEDICAL OFFICE

P O R T F O L I O

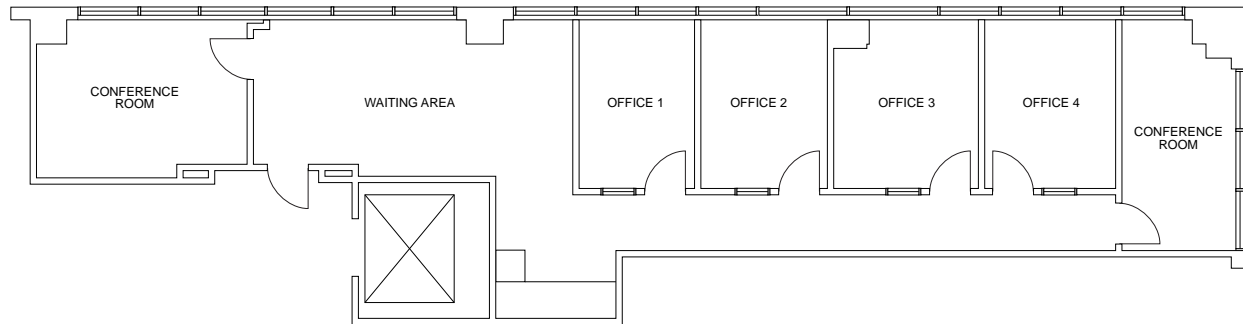

Suite 1160

1,421 RSF of Class A Medical Office Space

AS-BUILT SPACE PLAN

MARCUS YAMAMOTO

Senior Vice President
+1 206 292 6062
marcus.yamamoto@cbre.com

KATIE (PEARSON) SMITH

Senior Associate
+1 206 292 6012
katie.pearson@cbre.com

CBRE

Healthpeak
PROPERTIES

<http://properties.cbre.us/first-hill-medical-office-portfolio/>

© 2022 CBRE, Inc. All rights reserved. This information has been obtained from sources believed reliable, but has not been verified for accuracy or completeness. You should conduct a careful, independent investigation of the property and verify all information. Any reliance on this information is solely at your own risk. CBRE and the CBRE logo are service marks of CBRE, Inc. All other marks displayed on this document are the property of their respective owners, and the use of such logos does not imply any affiliation with or endorsement of CBRE. Photos herein are the property of their respective owners. Use of these images without the express written consent of the owner is prohibited.