

30
06

NORTHUP BUILDING

FOR MORE INFO
PLEASE CONTACT

LENNON ATTEBERRY

First Vice President
+1 425 462 6991
lennon.attedberry@cbre.com


CBRE, INC.

929 108th Avenue NE
Suite 700
Bellevue, WA 98004

CBRE

SUITE 101

AS-BUILT FLOOR PLAN | ± 1,372 RSF
AVAILABLE AUGUST 1, 2024

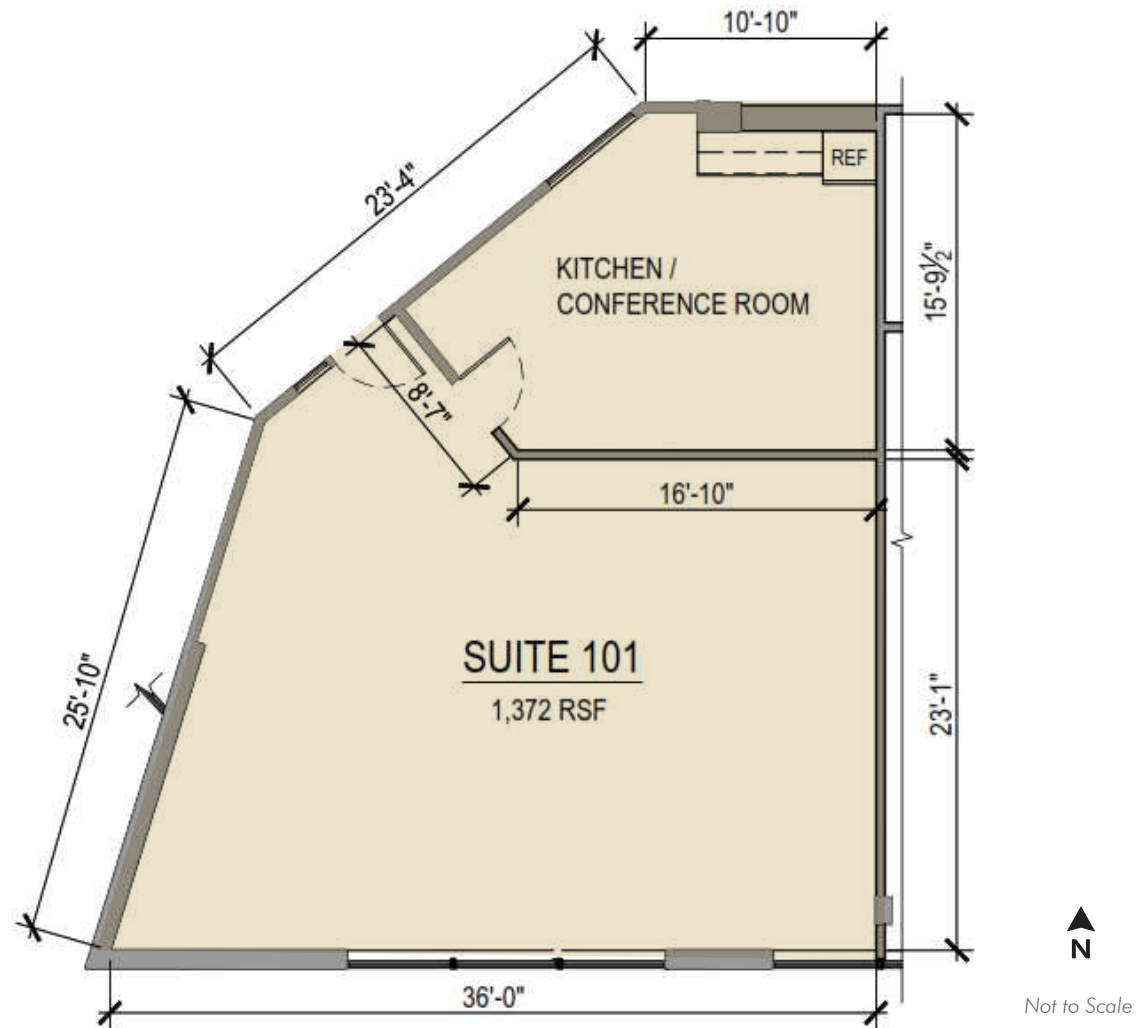

© 2024 CBRE, Inc. All rights reserved. This information has been obtained from sources believed reliable, but has not been verified for accuracy or completeness. You should conduct a careful, independent investigation of the property and verify all information. Any reliance on this information is solely at your own risk. CBRE and the CBRE logo are service marks of CBRE, Inc. Photos herein are the property of their respective owners and use of these images without the express written consent of the owner is prohibited. 03.11.2024 AL