



LOCATION:

Good central location situated on the north side of Sprague Avenue, just east of Freya and minutes to I-90 and the Central Business District. Average Weekday Traffic Flow Count per City of Spokane 2023 statistics is $\pm 17,500$ vehicles per 24 hours. Former location of Panoramic Dreams Recording Studio.

SITE:

A portion of a $\pm 13,800$ SF site; parcel #35154.0004

ZONING:

City of Spokane, GC-70, General Commercial

IMPROVEMENTS:

Building Footprint Area:	$\pm 1,725$ SF
Heat:	Central HVAC
Water & Sewer:	Serviced by City of Spokane
Construction Type:	Masonry, wood, and metal siding
Age:	1964
Utilities	Tenant pays separately metered gas & electric serviced by Avista Utilities.

2024 EXPENSES:

Estimated at \$225 per month; includes fire insurance, real estate taxes, water, sewer, garbage & minimal property management. Tenant provides its own parking lot maintenance including snow & ice removal, weed and pest control, repairs, maintenance and separately metered utilities.

LEASE PRICE:

\$1,725.00 (\$1.00/SF) per month + NNNs

OFFICE LOCATIONS

SPOKANE | COEUR D'ALENE | TRI-CITIES | PALOUSE | MISSOULA

**KIEMLE
HAGOOD**

All information herein is furnished by the owner and believed to be complete and correct. The Agent, however, cannot be responsible for changes, errors, omissions or withdrawals of this offering without notice. The above information is from sources deemed reliable but should be verified by parties that could be adversely affected by any statements or information. This is not an offering of sub-agency, with commission splits to be determined. 04/12/24/tp J:\BROKERS\LUCAS DOCS\FLYERS\Sprague E 3625 Lease.PUB



COMMERCIAL OFFICE / RETAIL

3625 E. Sprague Ave.,
Spokane, WA 99202

**View
Location**



MARK LUCAS, SIOR

509.755.7524


mlucas@kiemlehagood.com

TRACY LUCAS

509.755.7558

tracyl@kiemlehagood.com

601 W. Main Avenue, Suite 400
Spokane, WA 99201

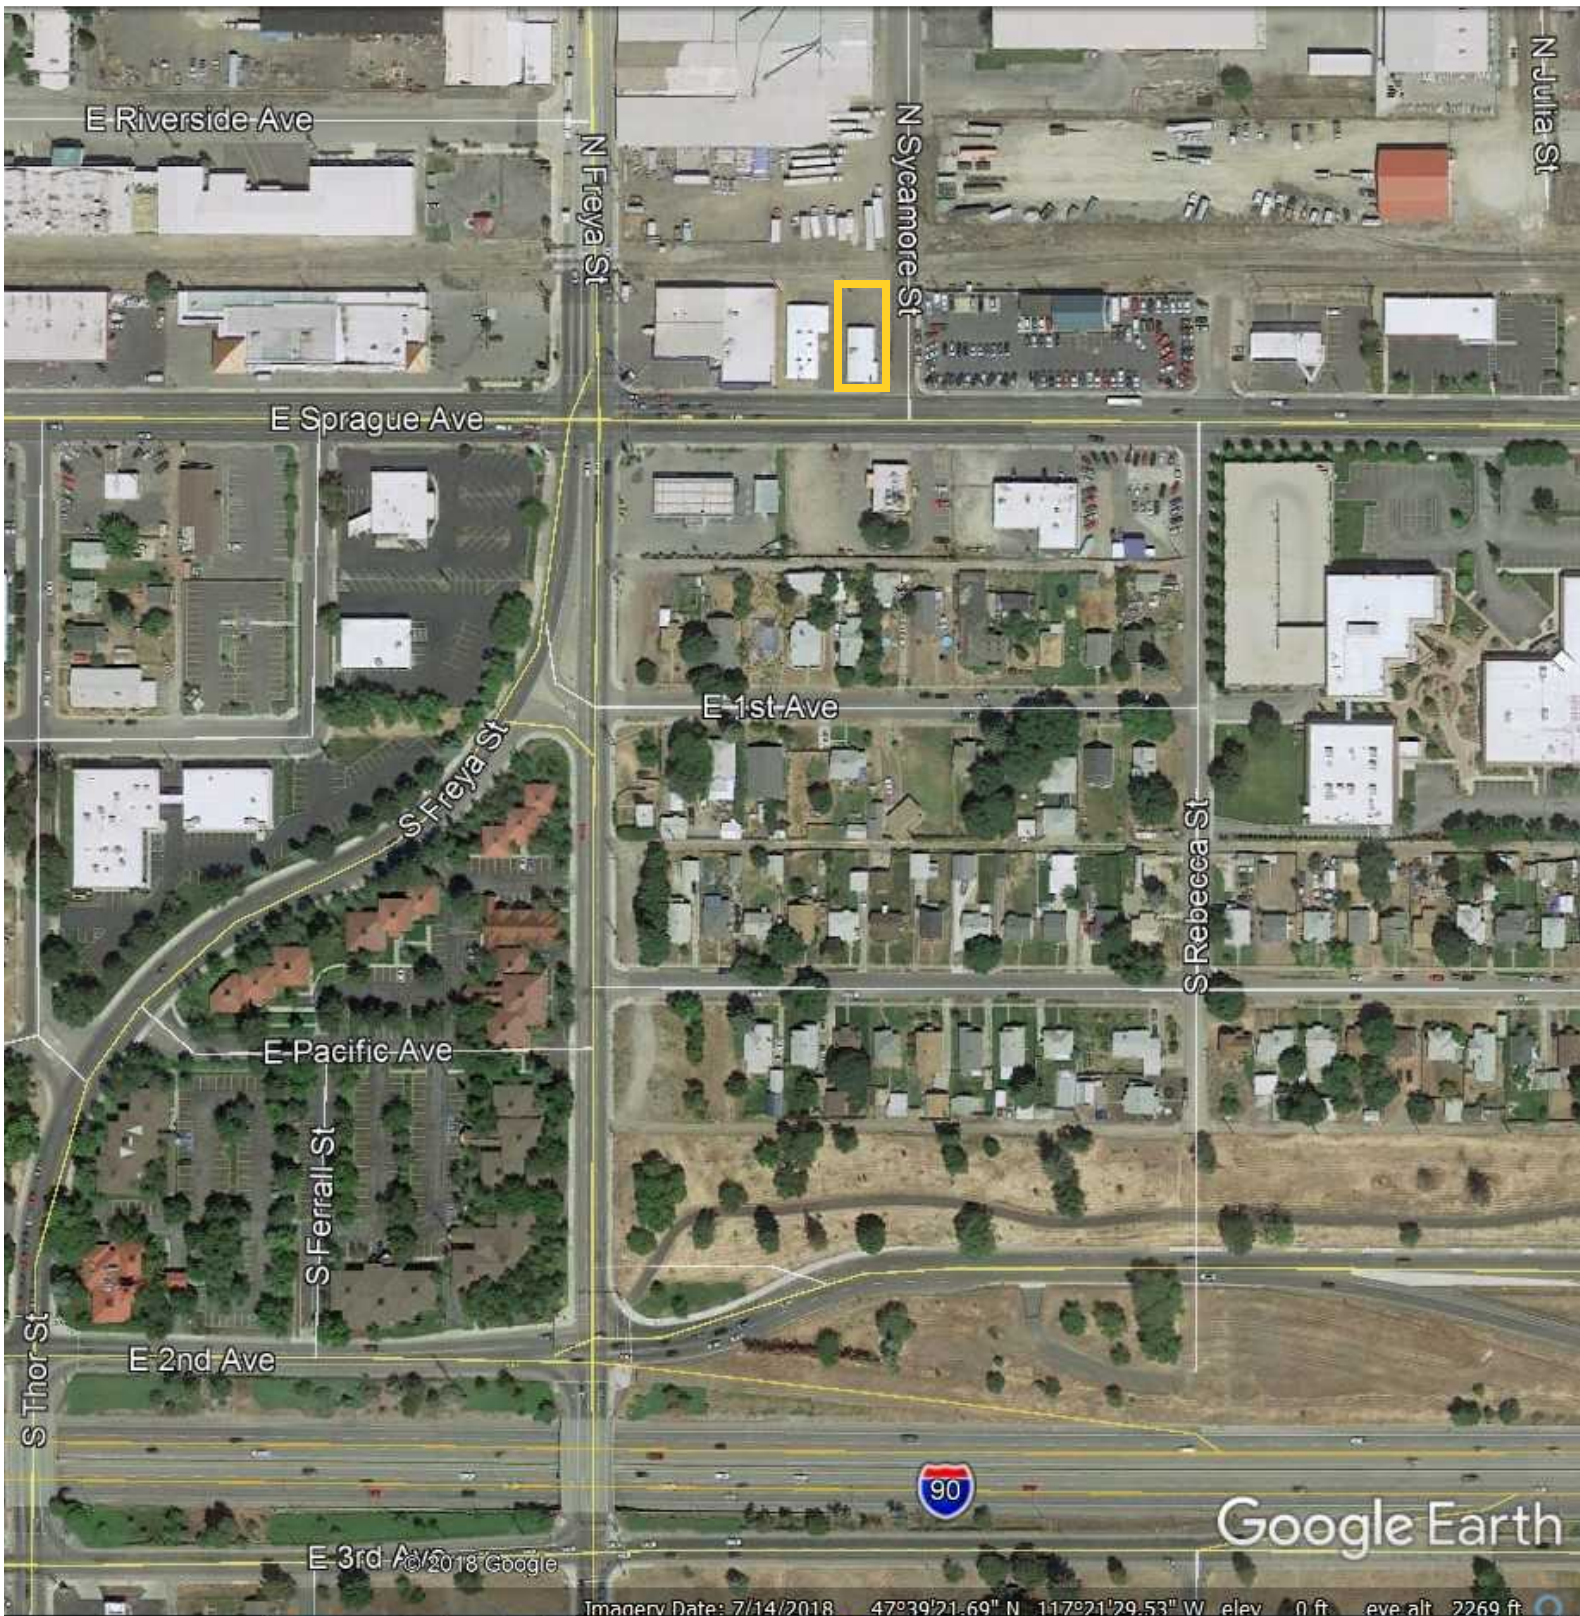

COMMERCIAL OFFICE/RETAIL | 3625 E. Sprague Ave., Spokane, WA 99202

Mark Lucas, SIOR | 509.755.7524 or mlucas@kiemlehagood.com

Tracy Lucas | 509.755.7558 or tracyl@kiemlehagood.com




Kiemle Hagood respects the intellectual property of others: If you believe the copyright in your work has been violated through this Website, please contact our office for notice of claims of copyright infringement. For your complaint to be valid under the Digital Millennium Copyright Act of 1998 (DMCA), you must provide the following information when providing notice of the claimed copyright infringement: Identify the material on the Website that you believe infringes your work, with enough detail so that we may locate it on the Website; provide your address, telephone number and email address; provide a statement that you have a good faith belief that the disputed use is not authorized by the copyright owner, its agent, or the law; provide a statement that the information in the notification is accurate, and under penalty of perjury, that the complaining party is authorized to act on behalf of owner of an exclusive right that is allegedly infringed; provide your physical or electronic signature. Upon receiving your complaint, Kiemle Hagood will, upon review, remove content that you believe infringes your copyright if the complaint is found valid.

FLOOR PLAN

3625 E. Sprague Ave., Spokane, WA 99202

AS-BUILT FOR 3625 E. SPRAGUE

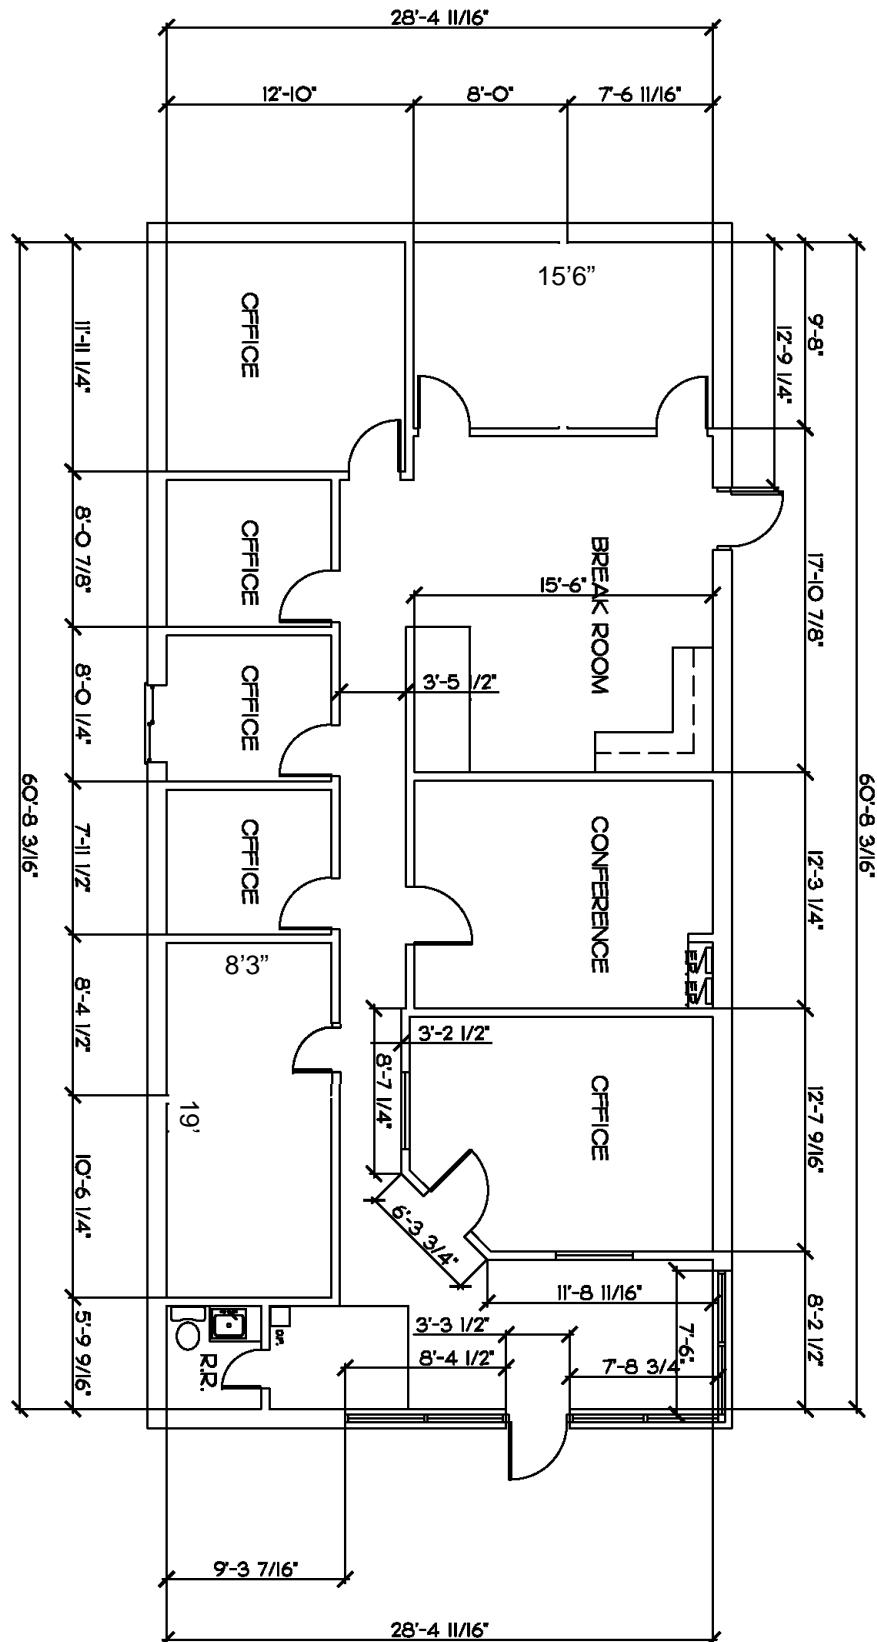

Mark
Lucas, SIOR | 509.755.7524 or mlucas@kiemlehagood.com

Tracy Lucas | 509.755.7558 or tracyl@kiemlehagood.com

MLE
HAGOOD