10700 NORTHUP WAY | BELLEVUE, WA 98004

10700 BUILDING





SPACE

HIGHLIGHTS

- + Available immediately
- + Master Lease Expires July 31, 2028
- + Shorter term subleases considered.
- + Plug and Play ready with furniture available
- + Parking ratio: 4.58 / 1,000 RSF (surface and covered available)
- + Centrally located between Downtown Kirkland and Downtown Bellevue
- + Easy access to SR-520 & I-405

SPACE AVAILABLE





ADDITIONAL FEATURES



Fitness center + showers



Adjacent to the Cross Kirkland Corridor trail



520 Bike Trail



Located next to South Kirkland Park and Ride




Close proximity to Kirkland amenities such as Carillon Point and the Lake Washington waterfront



AS-BUILT FLOOR PLAN

AVAILABLE 6/1/2025

SUITE 110 3,485 SF

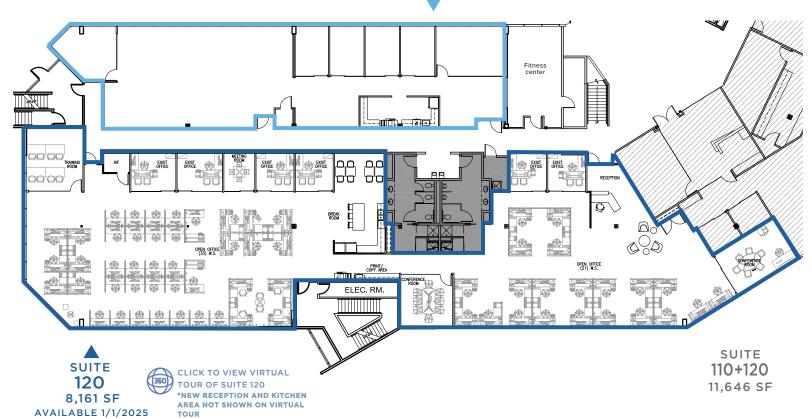







Sam Ziemba +1 425 974 4005

Jake Bos +1 425 974 4086 jake.bos@jll.com **Bailey Hicks** +1 425 974 4009

