



Suite 260 | 8,959 RSF

of Class A Medical Office Space

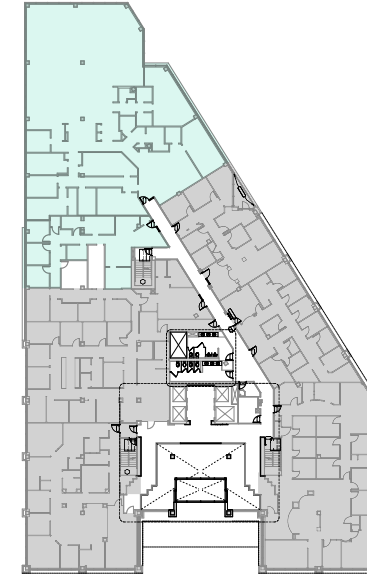

As-Built Space Plan

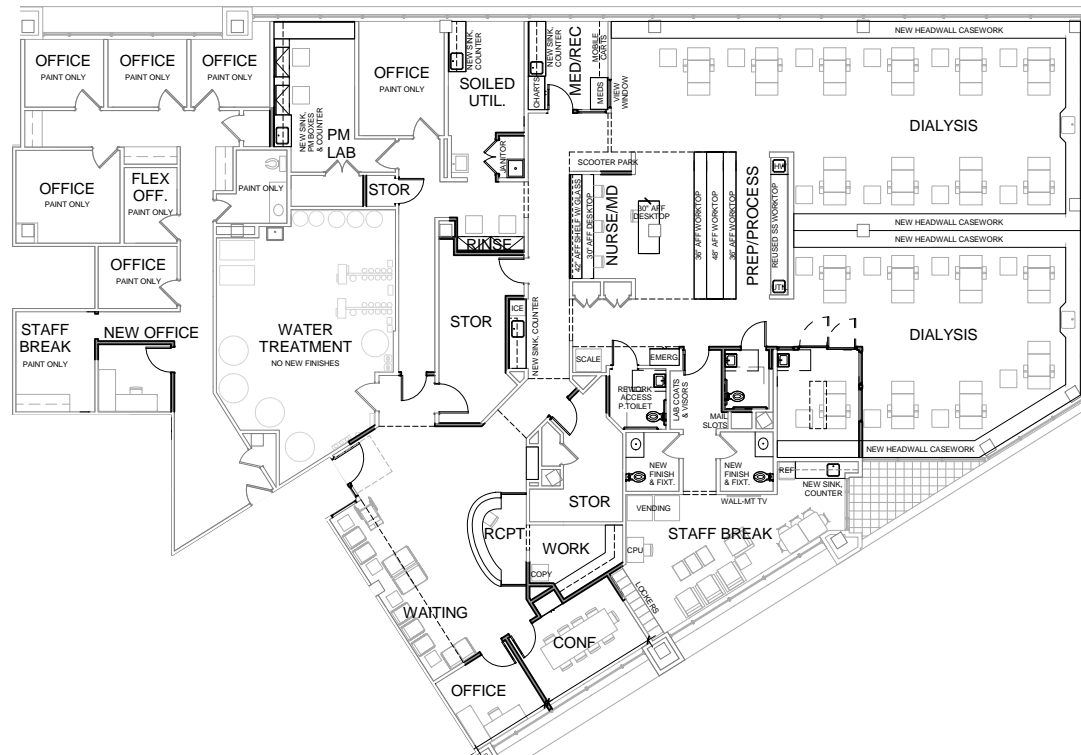

KEY

MARCUS YAMAMOTO
KATIE SMITH

Senior Vice President | marcus.yamamoto@cbre.com | +1 206 292 6062
Senior Associate | katie.m.smith@cbre.com | +1 206 292 6012

CBRE Healthpeak® | DOC
LISTED
NYSE



Suite 304 | 6,857 RSF

of Class A Medical Office Space



FIRST HILL
PORTFOLIO

As-Built Space Plan

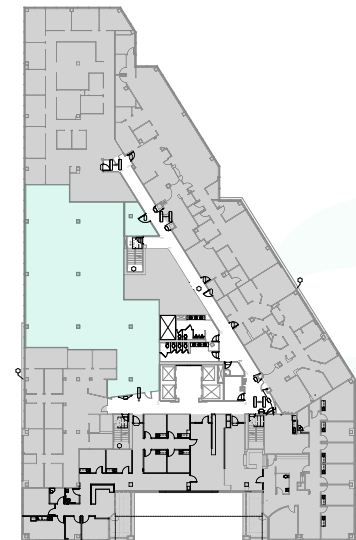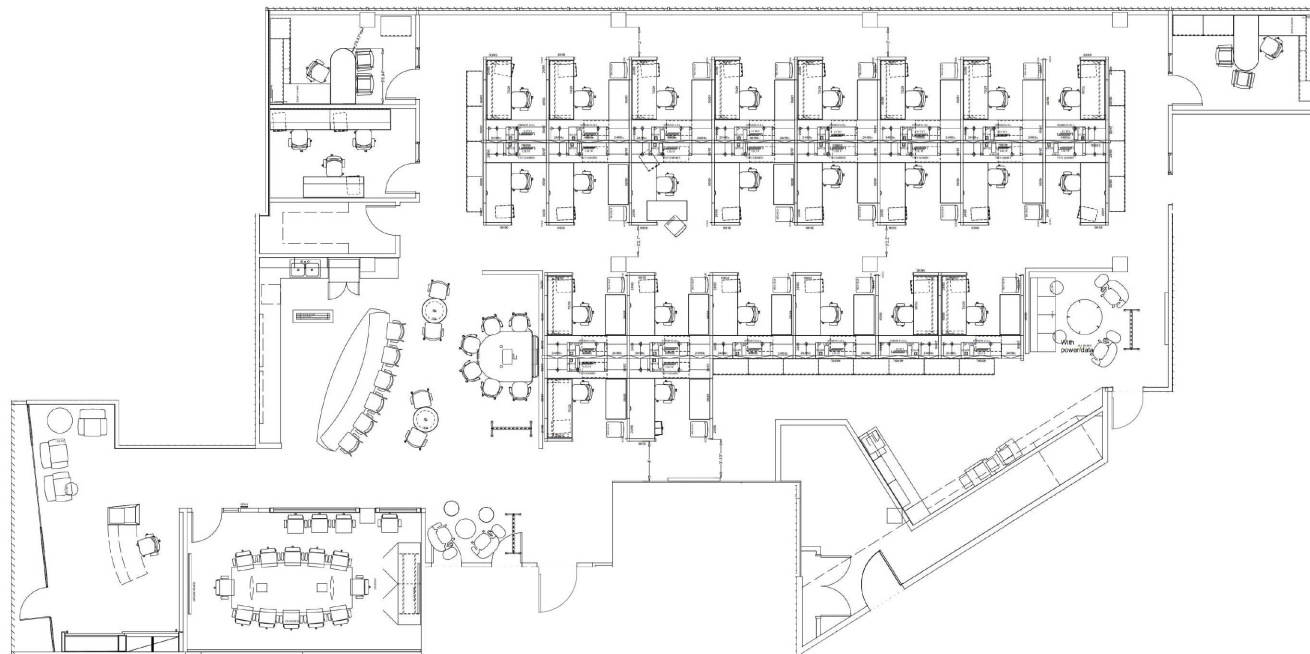

KEY

MARCUS YAMAMOTO

Senior Vice President | marcus.yamamoto@cbre.com | +1 206 292 6062

KATIE SMITH

Senior Associate | katie.m.smith@cbre.com | +1 206 292 6012

CBRE Healthpeak® | DOC
LISTED
NYSE



© 2024 CBRE, Inc. All rights reserved. This information has been obtained from sources believed reliable, but has not been verified for accuracy or completeness. You should conduct a careful, independent investigation of the property and verify all information. Any reliance on this information is solely at your own risk. CBRE and the CBRE logo are service marks of CBRE, Inc. All other marks displayed on this document are the property of their respective owners, and the use of such logos does not imply any affiliation with or endorsement of CBRE. Photos herein are the property of their respective owners. Use of these images without the express written consent of the owner is prohibited. PMStudio_June2024

Suite 304 | 6,857 RSF

of Class A Medical Office Space



Concept Plan - Clinic Space

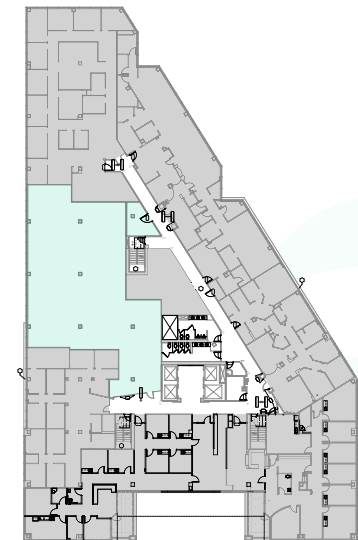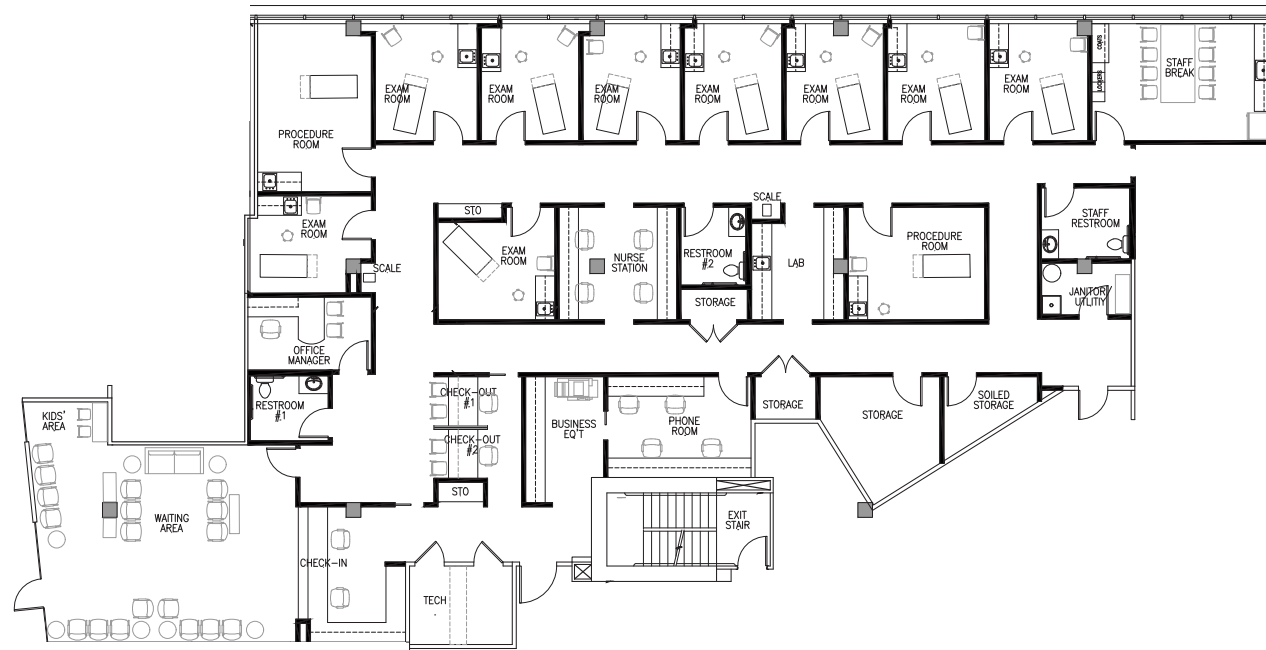

KEY

MARCUS YAMAMOTO Senior Vice President | marcus.yamamoto@cbre.com | +1 206 292 6062
 KATIE SMITH Senior Associate | katie.m.smith@cbre.com | +1 206 292 6012

CBRE Healthpeak® | DOC
ESTER
NYSE



Suite 490 | 3,137 RSF

of Class A Medical Office Space



FIRST HILL
PORTFOLIO

As-Built Space Plan

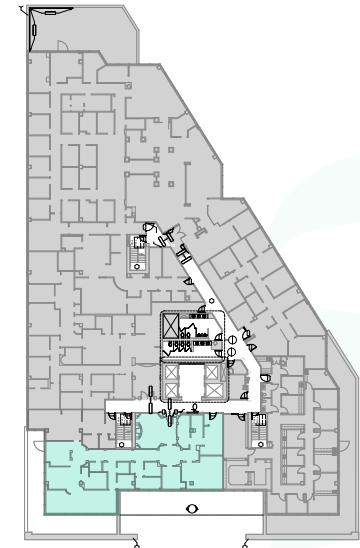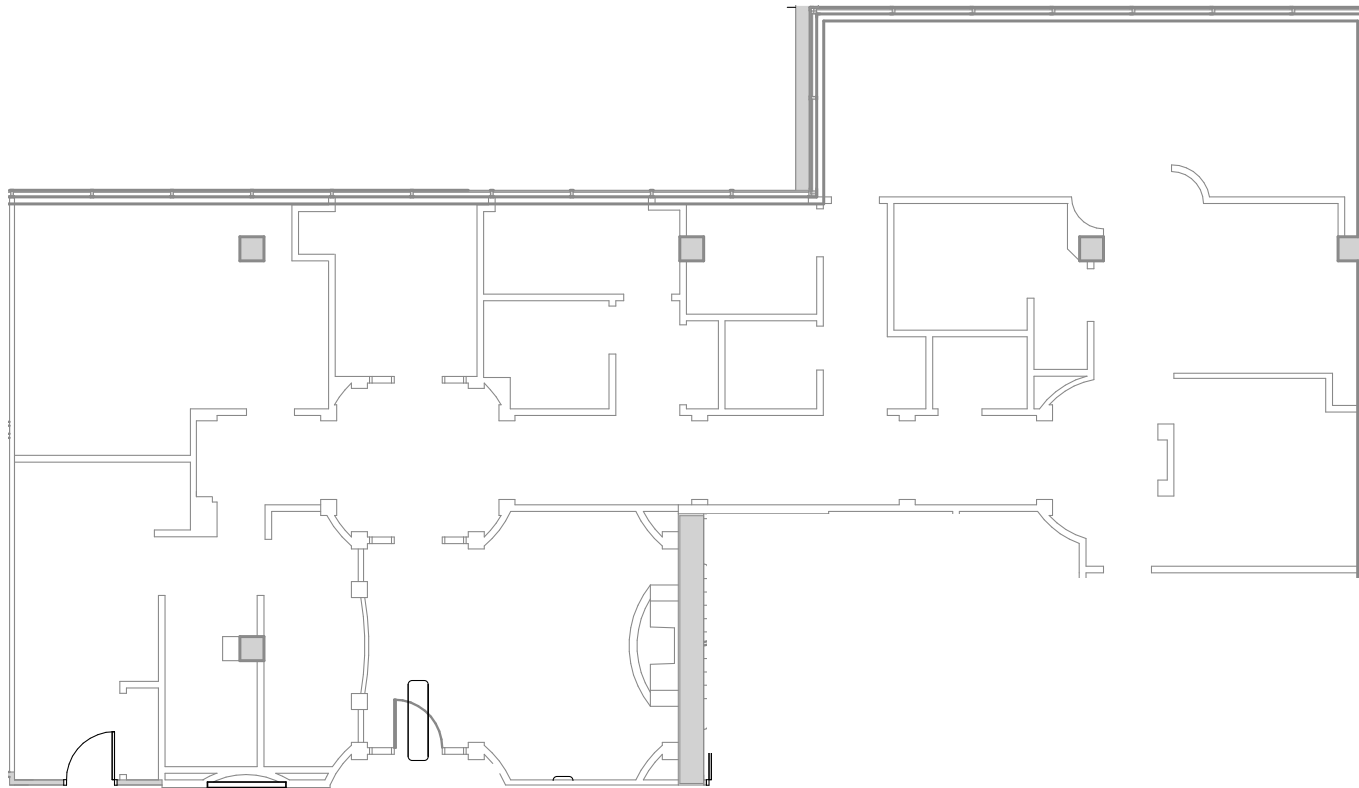

KEY

MARCUS YAMAMOTO

Senior Vice President | marcus.yamamoto@cbre.com | +1 206 292 6062

KATIE SMITH

Senior Associate | katie.m.smith@cbre.com | +1 206 292 6012

CBRE Healthpeak® | DOC
DISTRICT
NYSE


© 2024 CBRE, Inc. All rights reserved. This information has been obtained from sources believed reliable, but has not been verified for accuracy or completeness. You should conduct a careful, independent investigation of the property and verify all information. Any reliance on this information is solely at your own risk. CBRE and the CBRE logo are service marks of CBRE, Inc. All other marks displayed on this document are the property of their respective owners, and the use of such logos does not imply any affiliation with or endorsement of CBRE. Photos herein are the property of their respective owners. Use of these images without the express written consent of the owner is prohibited. PMStudio_June2024

Suite 490 | 3,846 RSF

of Class A Medical Office Space



As-Built Space Plan

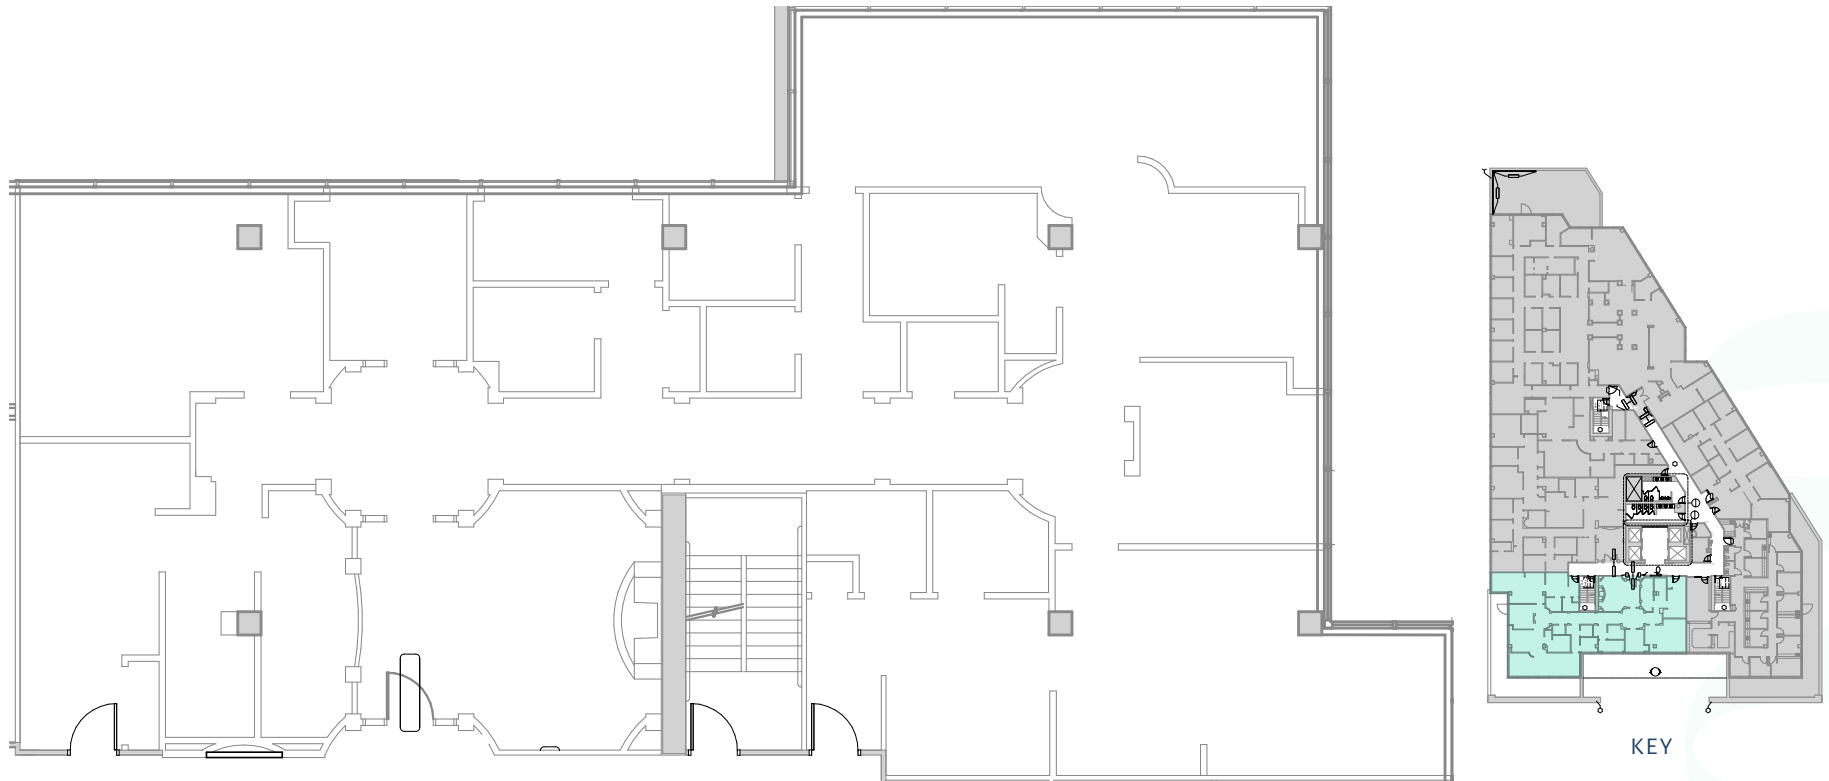

MARCUS YAMAMOTO
KATIE SMITH

Senior Vice President | marcus.yamamoto@cbre.com | +1 206 292 6062

Senior Associate | katie.m.smith@cbre.com | +1 206 292 6012



CBRE Healthpeak® | DOC
LISTED
NYSE

Suite 490 | 3,846 RSF

of Class A Medical Office Space



Concept Plan - Medical

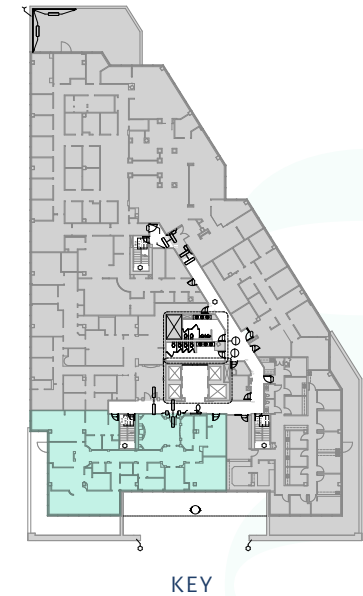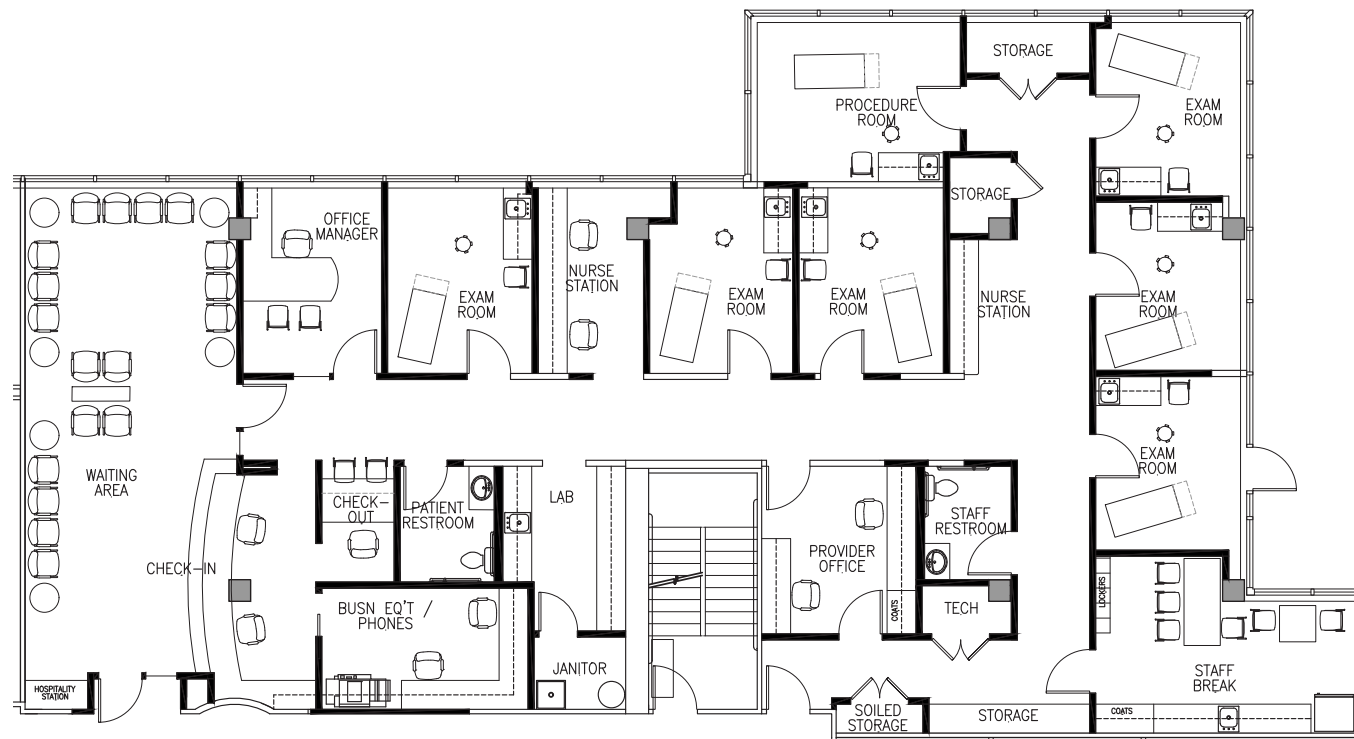

MARCUS YAMAMOTO
KATIE SMITH

Senior Vice President | marcus.yamamoto@cbre.com | +1 206 292 6062

Senior Associate | katie.m.smith@cbre.com | +1 206 292 6012



CBRE Healthpeak® | DOC
LISTED
NYSE

Suite 490 | 3,846 RSF

of Class A Medical Office Space



Concept Plan - Dental

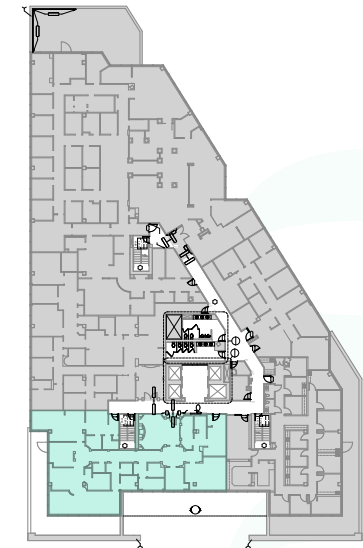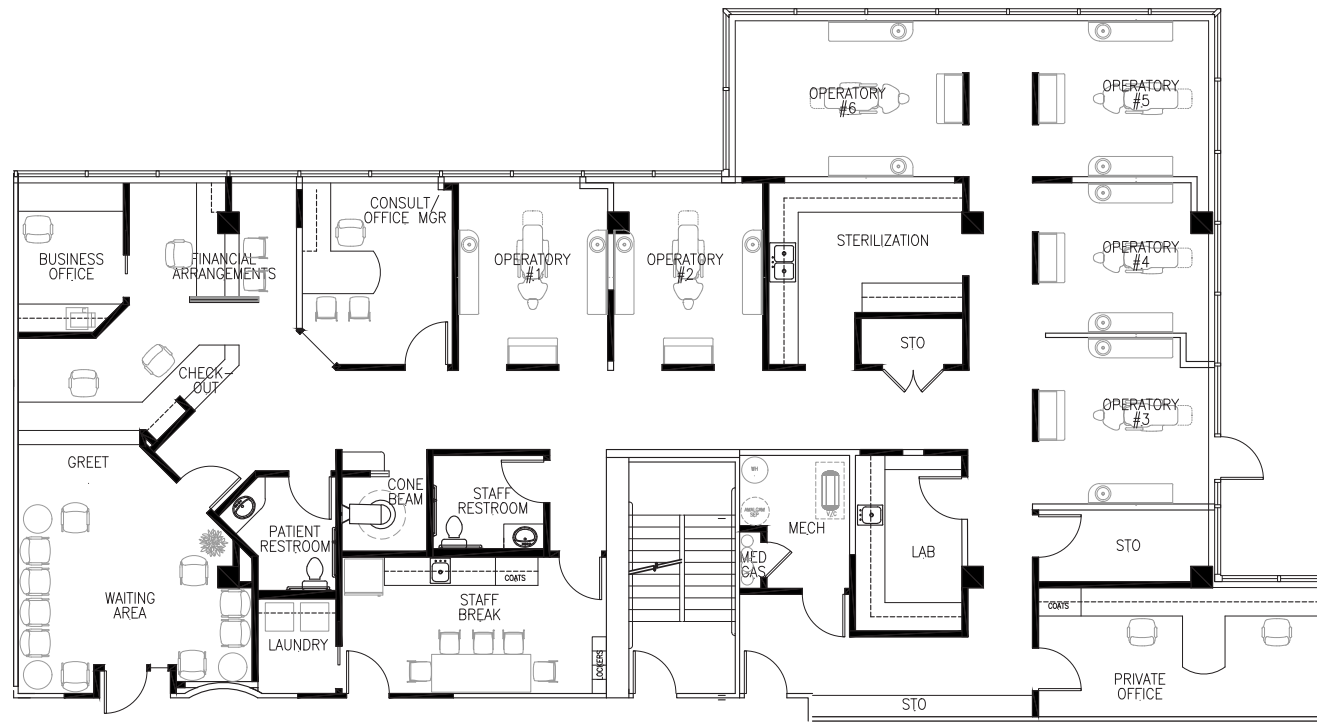

KEY

MARCUS YAMAMOTO
KATIE SMITH

Senior Vice President | marcus.yamamoto@cbre.com | +1 206 292 6062
Senior Associate | katie.m.smith@cbre.com | +1 206 292 6012



CBRE Healthpeak® | DOC
ESTER
NYSE

Suite 510 | 2,115 RSF

of Class A Medical Office Space



As-Built Space Plan

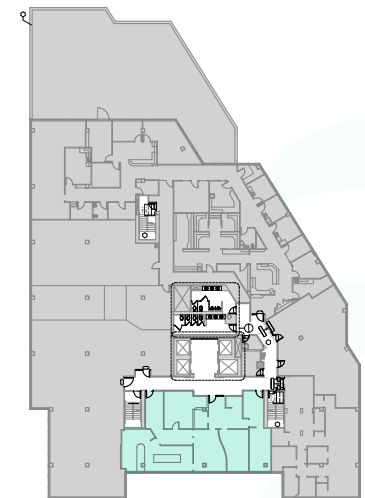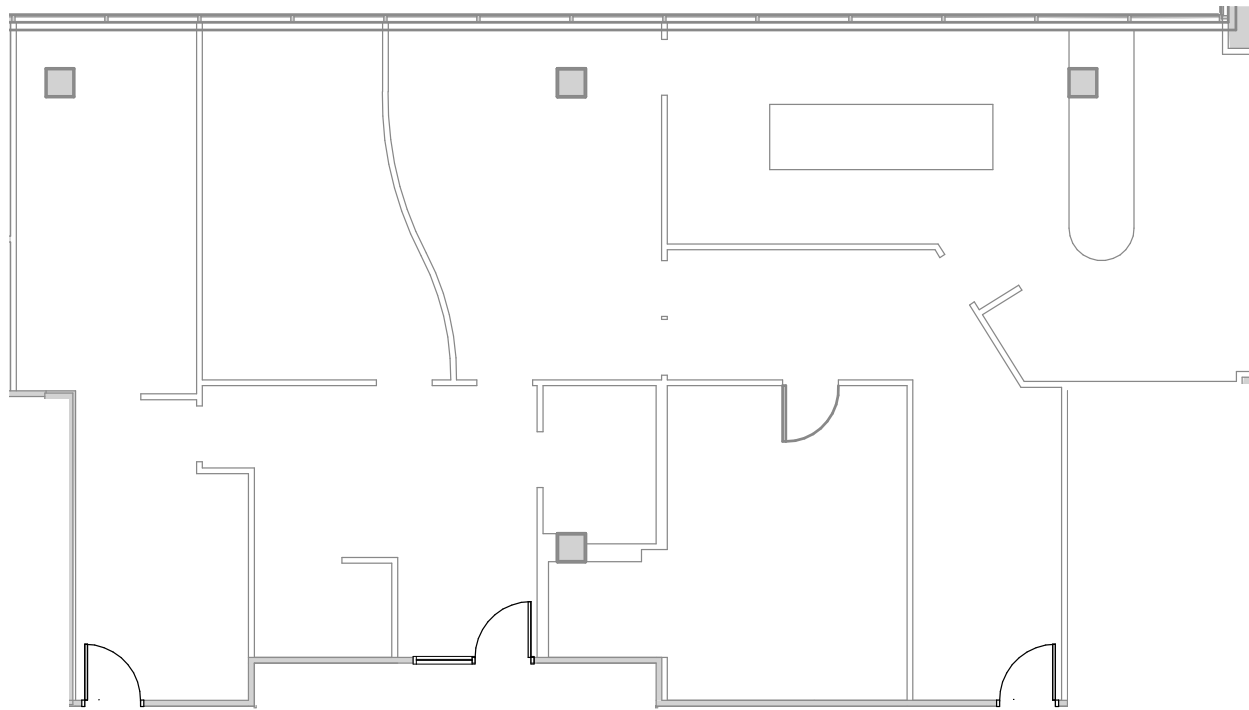

KEY

MARCUS YAMAMOTO
KATIE SMITH

Senior Vice President | marcus.yamamoto@cbre.com | +1 206 292 6062

Senior Associate | katie.m.smith@cbre.com | +1 206 292 6012



CBRE Healthpeak® | DOC
LISTED
NYSE

Suite 610 | 8,706 RSF

of Class A Medical Office Space



As-Built Space Plan

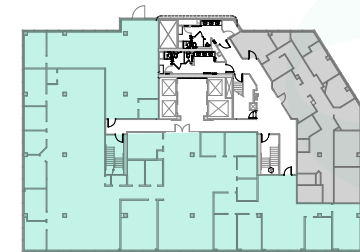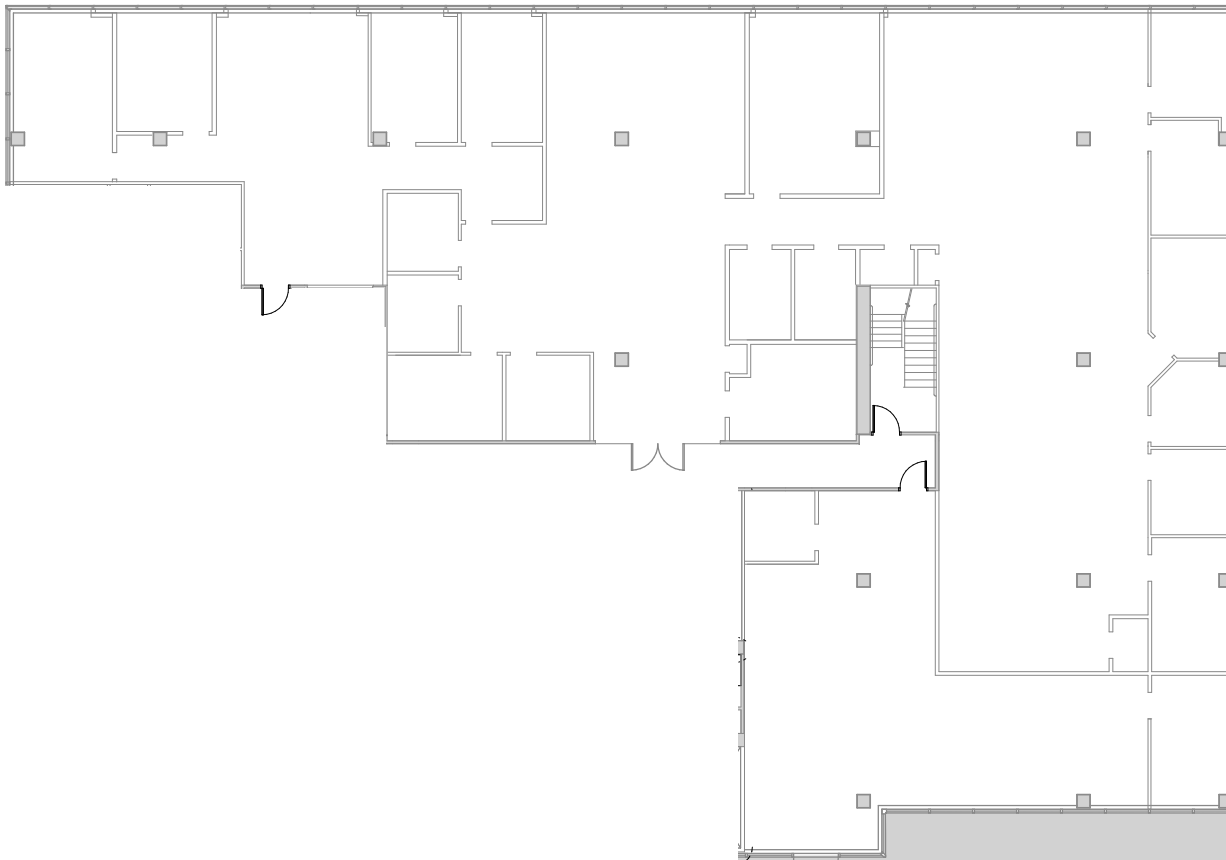

KEY

MARCUS YAMAMOTO
KATIE SMITH

Senior Vice President | marcus.yamamoto@cbre.com | +1 206 292 6062

Senior Associate | katie.m.smith@cbre.com | +1 206 292 6012

CBRE Healthpeak® | DOC
LISTED
NYSE