



Suite 110 | ±14,131 RSF  
 Available Now  
 As-Built Plan

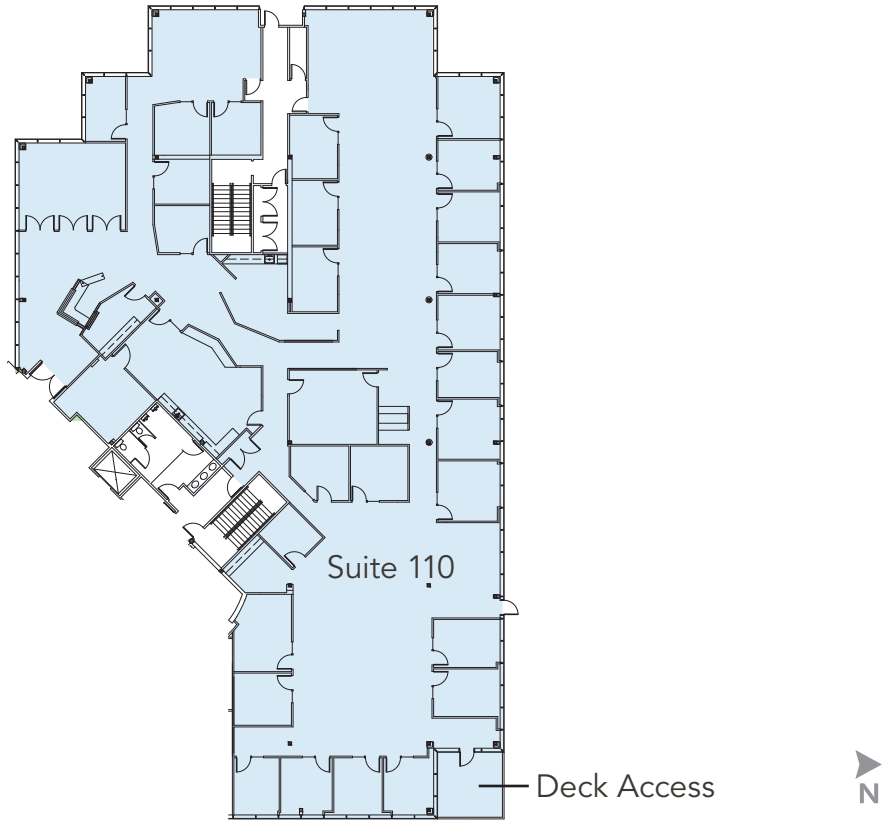

KEY SITE PLAN

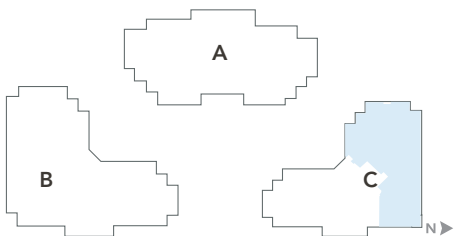

FOR OFFICE LEASING INFORMATION, PLEASE CONTACT:

**SCOTT DAVIS**  
 Executive Vice President  
 +1 425 941 7573  
 scott.davis@cbre.com


**TIM OWENS**  
 Senior Vice President  
 +1 425 462 6913  
 tim.owens@cbre.com

**CBRE, Inc.**  
 929 108th Ave NE  
 Suite 700  
 Bellevue, WA 98004




© 2024 CBRE, Inc. This information has been obtained from sources believed reliable. We have not verified it and make no guarantee, warranty or representation about it. Any projections, opinions, assumptions or estimates used are for example only and do not represent the current or future performance of the property. You and your advisors should conduct a careful, independent investigation of the property to determine to your satisfaction the suitability of the property for your needs. CBRE and the CBRE logo are service marks of CBRE, Inc. and/or its affiliated or related companies in the United States and other countries. All other marks displayed on this document are the property of their respective owners. DW 7.30.24

Suite 110 | ±14,131 RSF  
Available Now  
Conceptual Plan

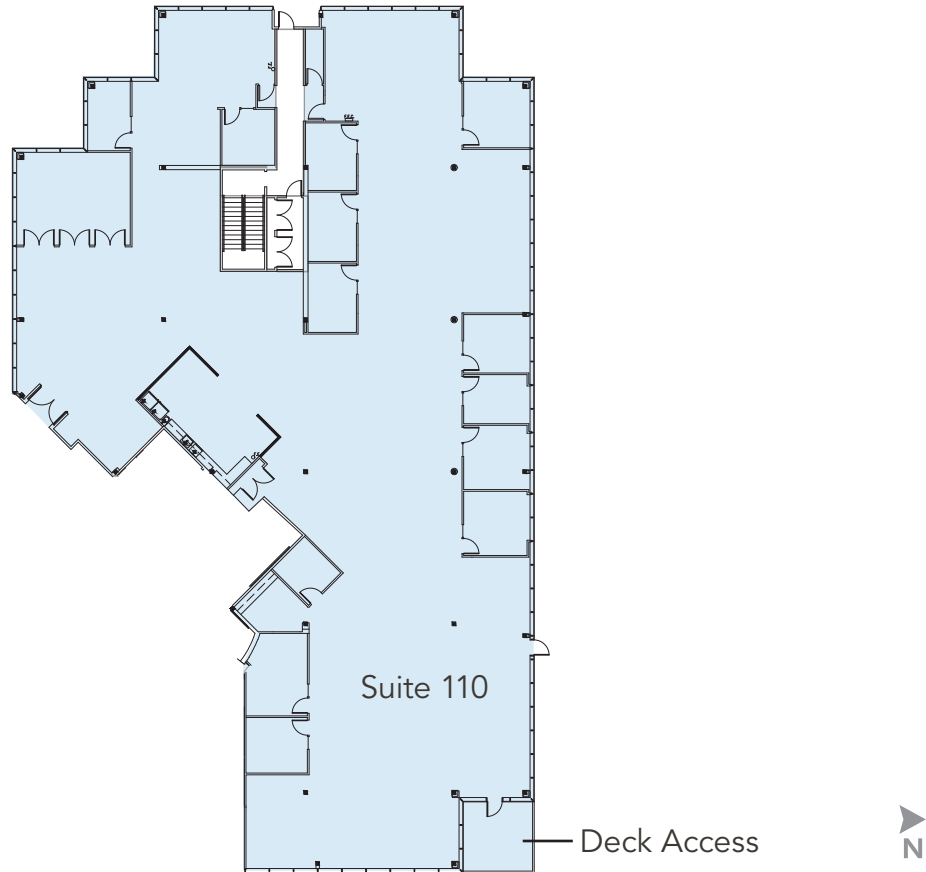

KEY SITE PLAN

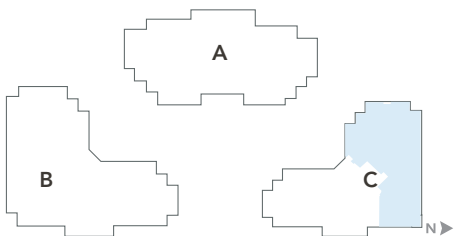

FOR OFFICE LEASING INFORMATION, PLEASE CONTACT:

**SCOTT DAVIS**  
Executive Vice President  
+1 425 941 7573  
scott.davis@cbre.com

**TIM OWENS**  
Senior Vice President  
+1 425 462 6913  
tim.owens@cbre.com

**CBRE, Inc.**  
929 108th Ave NE  
Suite 700  
Bellevue, WA 98004



© 2024 CBRE, Inc. This information has been obtained from sources believed reliable. We have not verified it and make no guarantee, warranty or representation about it. Any projections, opinions, assumptions or estimates used are for example only and do not represent the current or future performance of the property. You and your advisors should conduct a careful, independent investigation of the property to determine to your satisfaction the suitability of the property for your needs. CBRE and the CBRE logo are service marks of CBRE, Inc. and/or its affiliated or related companies in the United States and other countries. All other marks displayed on this document are the property of their respective owners. DW 7.30.24