



FOR MORE
INFORMATION,
PLEASE CONTACT

LENNON ATTEBERRY
First Vice President
+1 425 462 6991
lennon.attedberry@cbre.com


CBRE, INC.
929 108th Avenue NE
Suite 700
Bellevue, WA 98004



SUITE 101

AS-BUILT FLOOR PLAN | ± 1,372 RSF

AVAILABLE MARCH 1, 2025

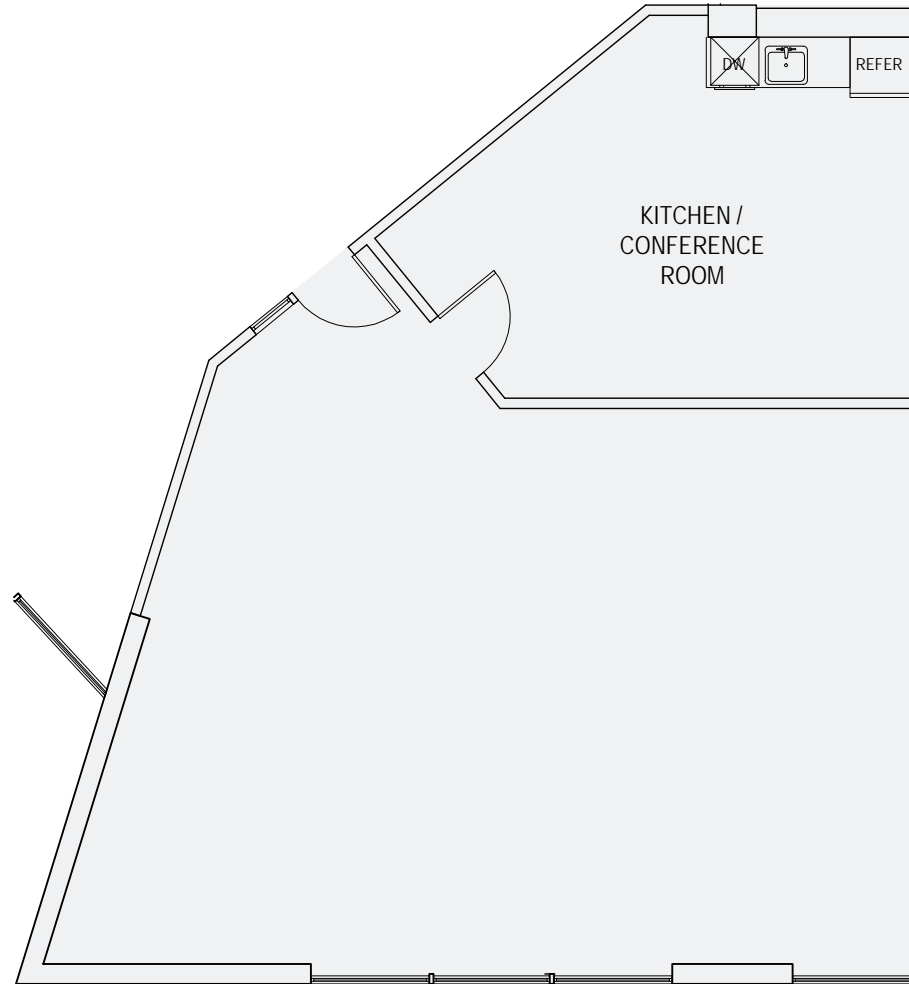

© 2024 CBRE, Inc. All rights reserved. This information has been obtained from sources believed reliable, but has not been verified for accuracy or completeness. You should conduct a careful, independent investigation of the property and verify all information. Any reliance on this information is solely at your own risk. CBRE and the CBRE logo are service marks of CBRE, Inc. All other marks displayed on this document are the property of their respective owners, and the use of such logos does not imply any affiliation with or endorsement of CBRE. Photos herein are the property of their respective owners. Use of these images without the express written consent of the owner is prohibited. PMStudio_October2024