

Point White Drive NE

2-D AS-BUILT FLOOR PLANS

2DELOORPIANS.COM

371 NW Gilman Blvd.
Suite 140
Issaquah, WA 98027
425-677-7511


This drawing is an instrument of service and is the sole property of the client listed. Any alteration of this drawing without removal of references to 2-D As-Built Floor Plans, Inc. is prohibited.

Drawing scale and dimensions are provided for reference only. Refer to CAD files for exact measurements.

©2010 2-D As-Built Floor Plans, Inc.
All Rights Reserved.

Neighboring Property

For Lease
— 2,669 sqft

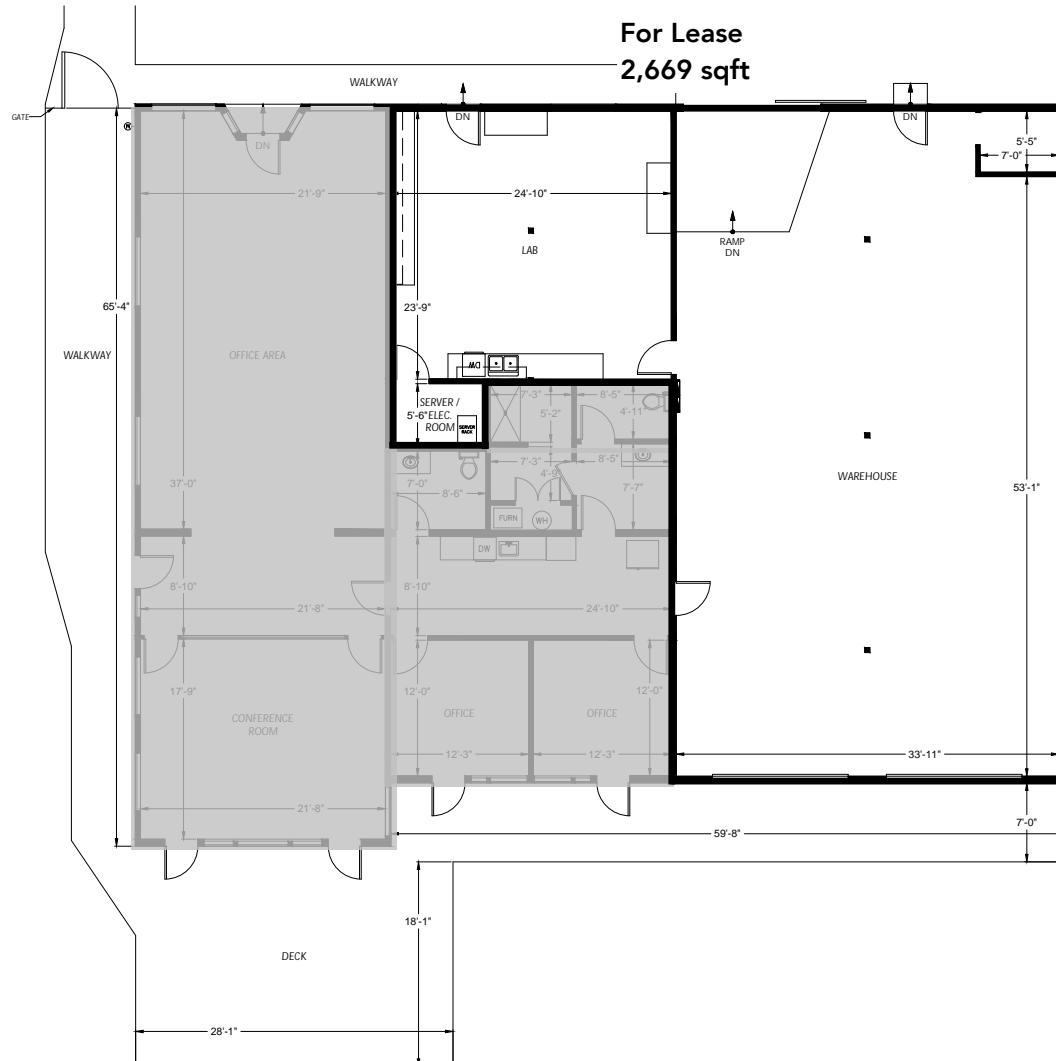

Puget Sound



Scale: 3/32" = 1'-0"

Floor Plan

1

1

Floor

Point White Drive NE

For Lease
- 2,669 sqft

2-D AS-BUILT FLOOR PLANS

2DEFL00RPI.ANS.COM

371 NW Gilman Blvd.
Suite 140
Issaquah, WA 98027
425-677-7511

This drawing is an instrument of service and is the sole property of the client listed. Any alteration of this drawing without removal of references to 2-D As-Built Floor Plans, Inc. is prohibited.

Drawing scale and dimensions are provided for reference only. Refer to CAD files for exact measurements.

©2010 2-D As-Built Floor Plans, Inc.
All Rights Reserved.

Area Analysis performed
in accordance with
ANSI/BOMA Z65.1 - 2024
Method A Standard.

Project: C25-332

Client:
Windermere Commercial
360 Tormey Lane NE, #298
Bainbridge Island, WA 98110

Site:
Office/Warehouse Building
4566 Point White Drive NE
Bainbridge Island, WA 98110



Lease Plan

1

Floor

Floor Summary	SQ. FT.
Total Occupant Area	4,937.18
Suite #	Occupant Area
Office	2,269.05
Lab	660.23
Warehouse	2,007.90
Deck	1,447.63

Puget Sound

