


# NORTH CREEK BUSINESS CENTER BUILDING 'D' FLOOR PLAN

SCALE : 3/16" = 1' - 0"

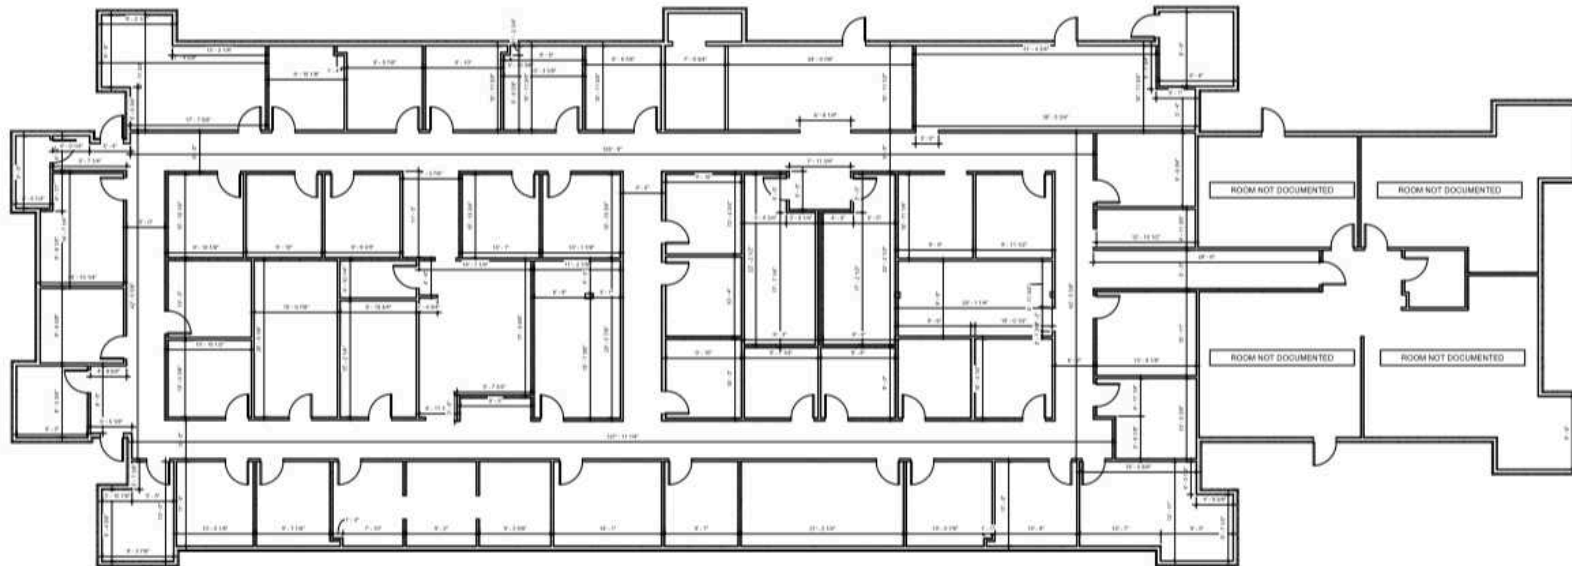

## AS-BUILT NOTES:

- DRAWINGS REFLECT AS-BUILT CONDITIONS BASED ON AVAILABLE DOCUMENTATION AND FIELD VERIFICATION. REPORT DISCREPANCIES TO THE OWNER, ARCHITECT, OR RESPECTIVE DESIGNER.
- ALL DIMENSIONS ARE FINISH-TO-FINISH UNLESS FINISHES ARE MISSING. FIELD VERIFY ALL DIMENSIONS PRIOR TO COMMENCING WORK.
- ELECTRICAL, MECHANICAL, FIRE-RESISTIVE ASSEMBLIES, FINISHES, AND EQUIPMENT ARE NOT DOCUMENTED. VERIFICATION BY RESPECTIVE CONSULTANTS AND ENGINEERS REQUIRED.
- MAINTAIN THE INTEGRITY OF FIRE-RATED ASSEMBLIES, INCLUDING WALLS, DOORS, AND PENETRATIONS, PER APPLICABLE CODES.
- PROVIDE PROTECTION FOR EXISTING FINISHES, EQUIPMENT, AND ADJACENT AREAS THROUGHOUT THE DURATION OF WORK.
- REFER TO 'NORTH CREEK BUSINESS CENTER - BUILDING D FLOOR PLAN' FOR WINDOW LOCATIONS.