


1110 N SAMISH WAY BELLINGHAM, WA 98225


A1



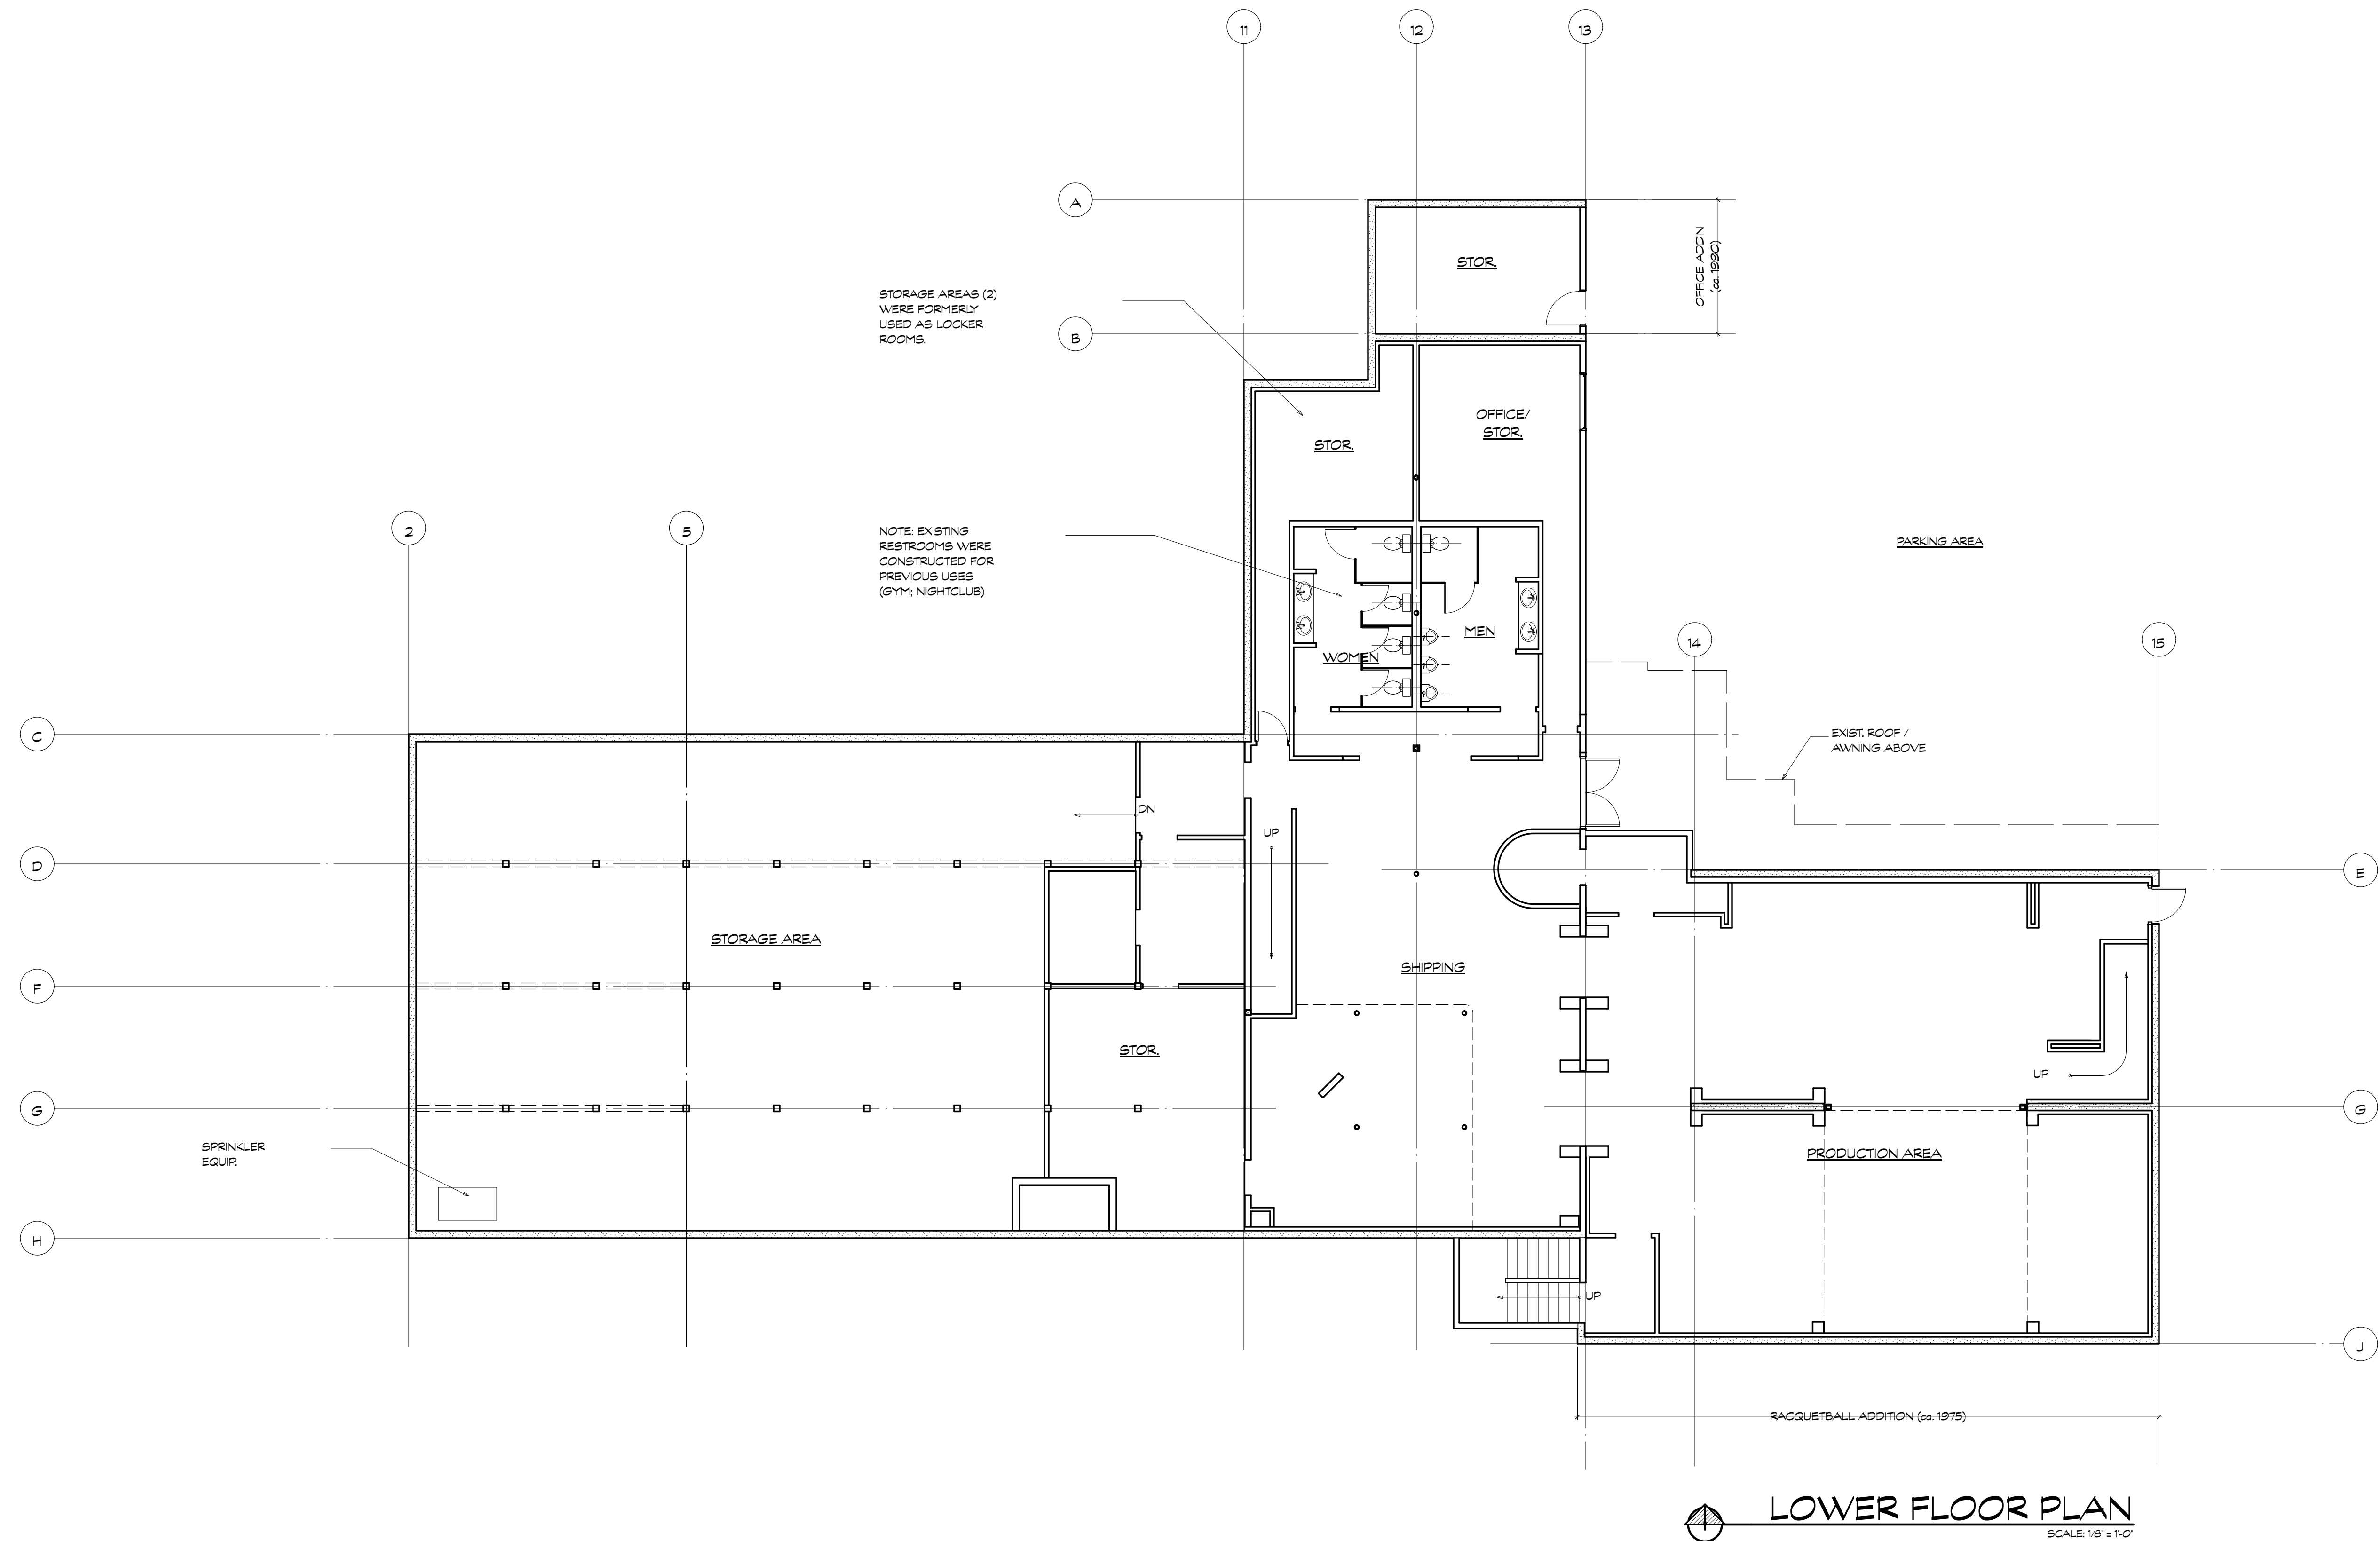

100 Pine Street
Bellingham, WA 98225
curt@carpenterarch.com
(360) 714-1808

110 N SAMISH WAY BELLINGHAM, WA 98225

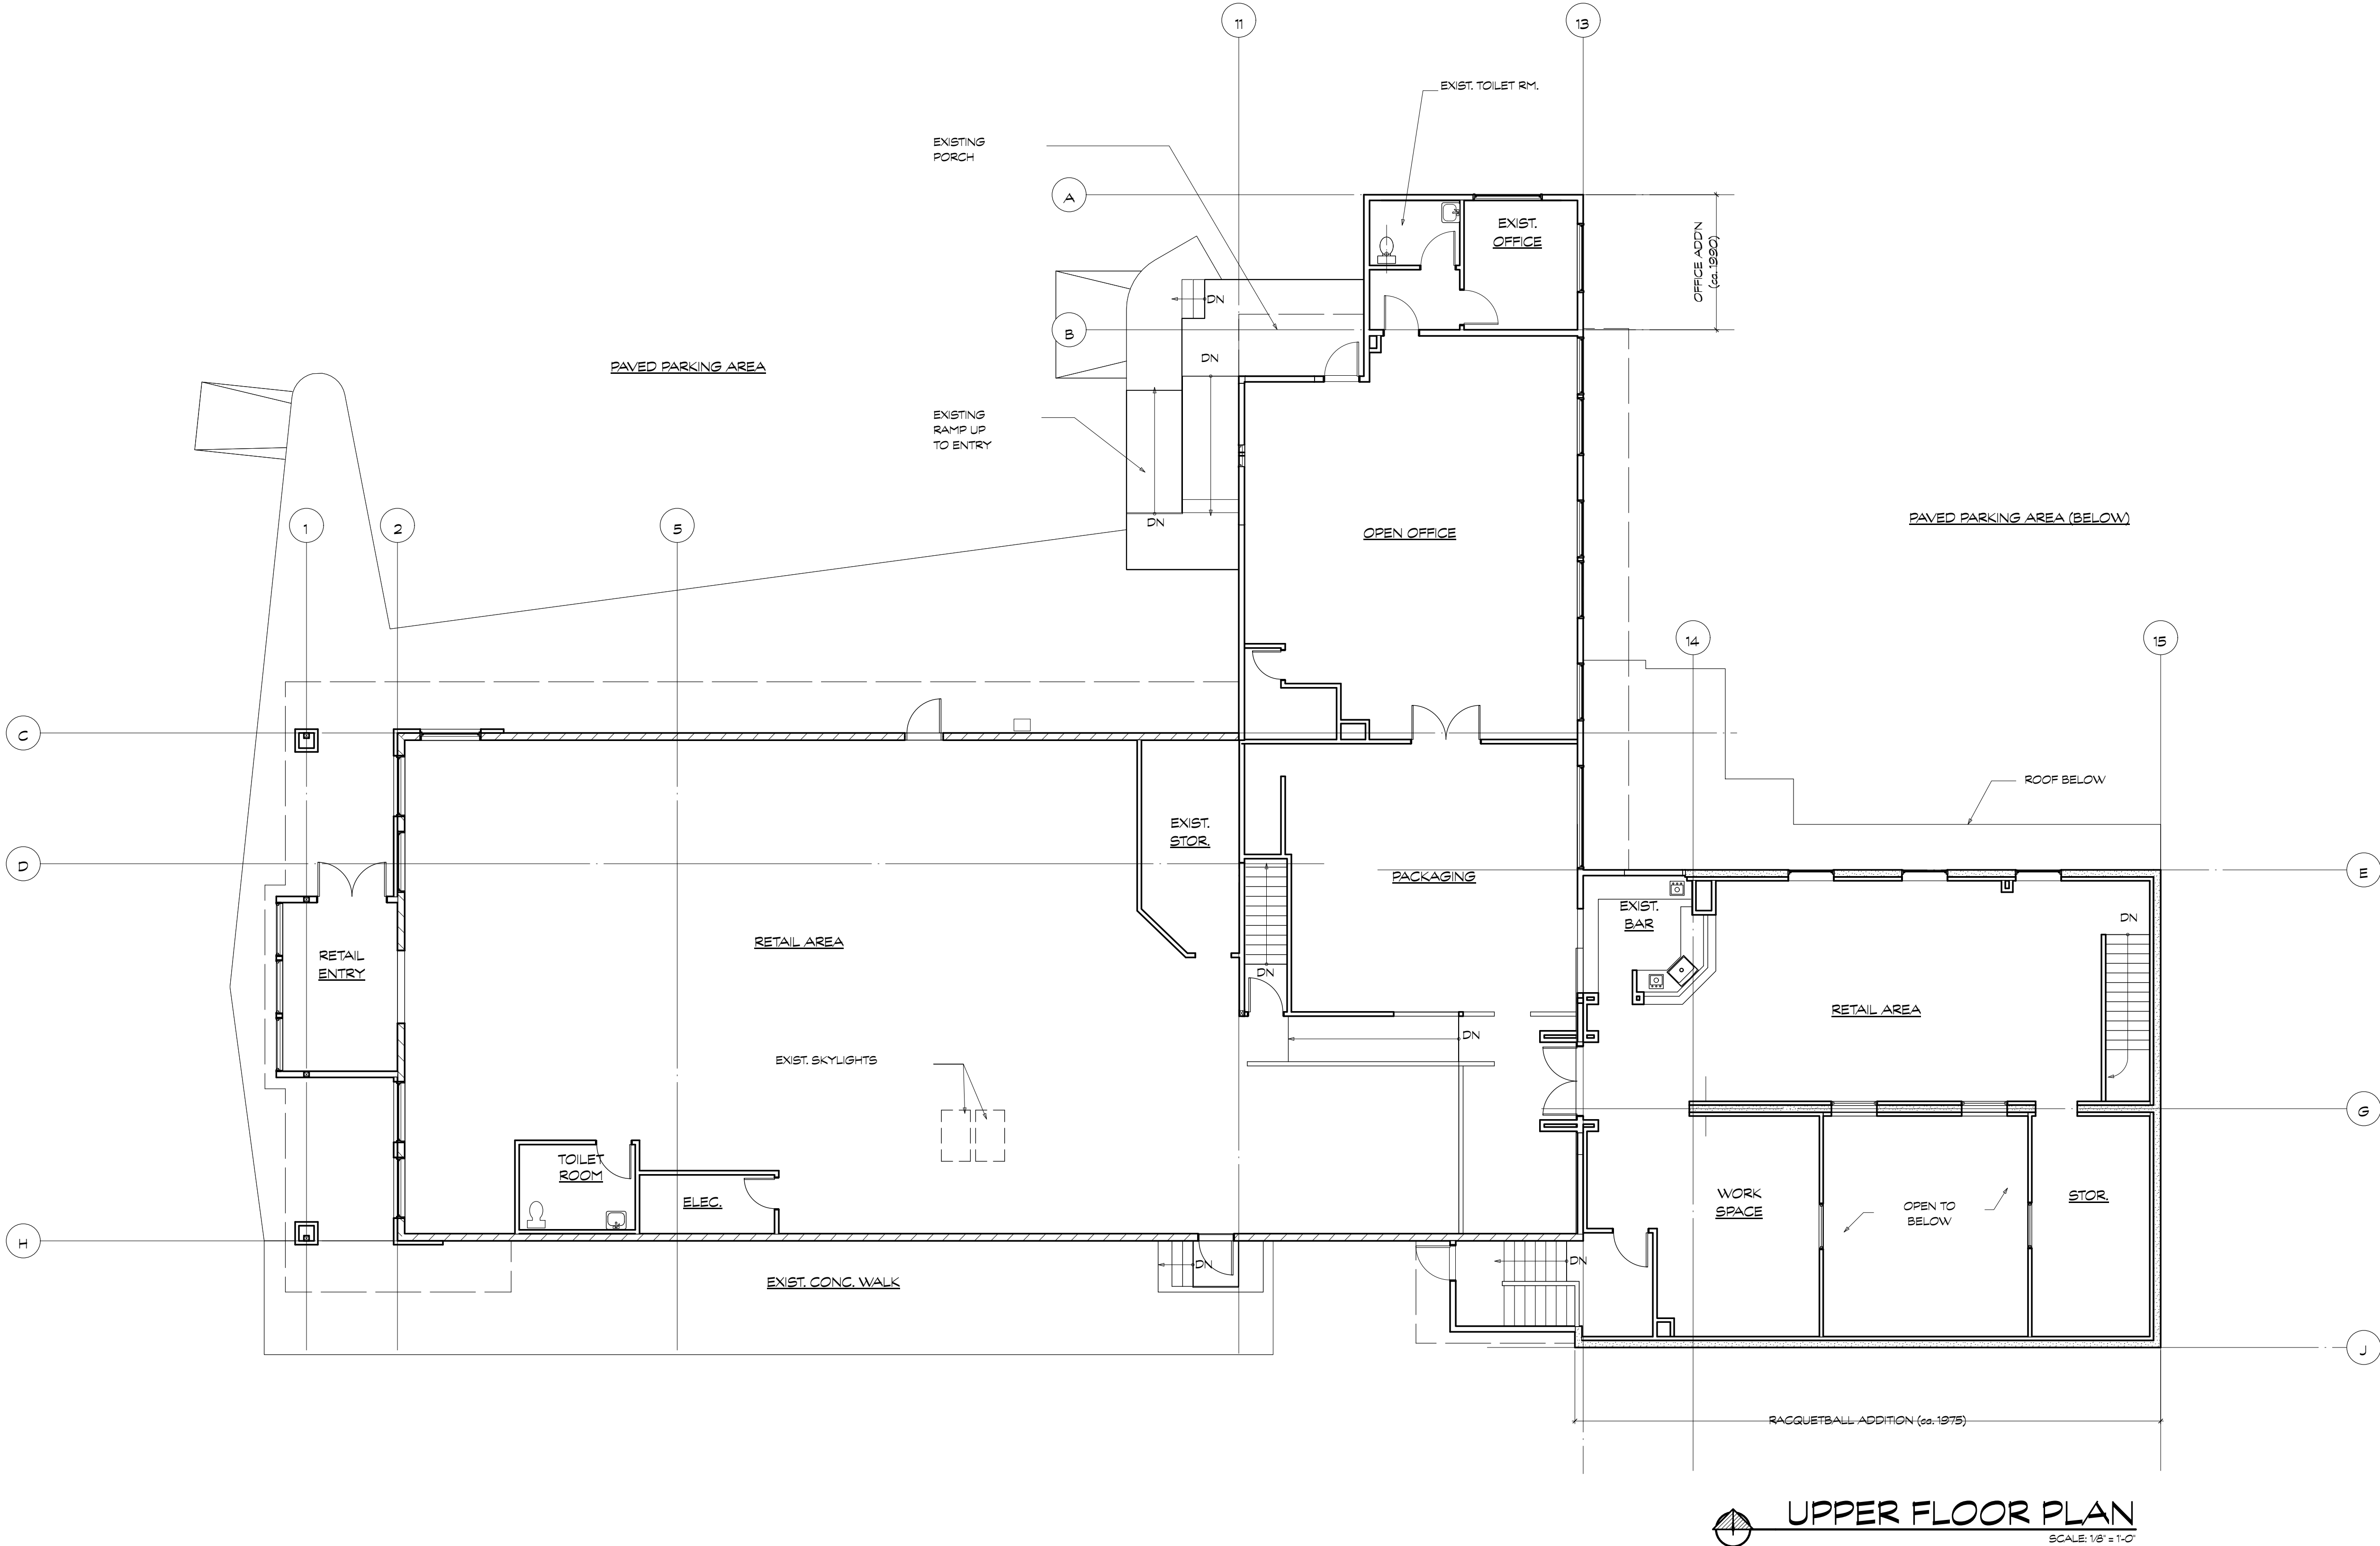

UPPER FLOOR PLAN
SCALE: 1/8" = 1'-0"

EXISTING

NOVEMBER 21, 2022

REVISIONS:

THIS DOCUMENT REPRESENTS A PROPRIETARY DESIGN OWNED BY THE ARCHITECT AND SHALL NOT BE USED ON OTHER PROJECTS, FOR ADDITIONS TO THIS PROJECT, OR FOR COMPLETION OF THIS PROJECT BY OTHERS, EXCEPT BY PRIOR AGREEMENT IN WRITING. © CARPENTER ARCHITECTS

UPPER FLOOR PLAN

A2