



Suite 110 | ±14,227 SF
Available Now
As-Built Plan

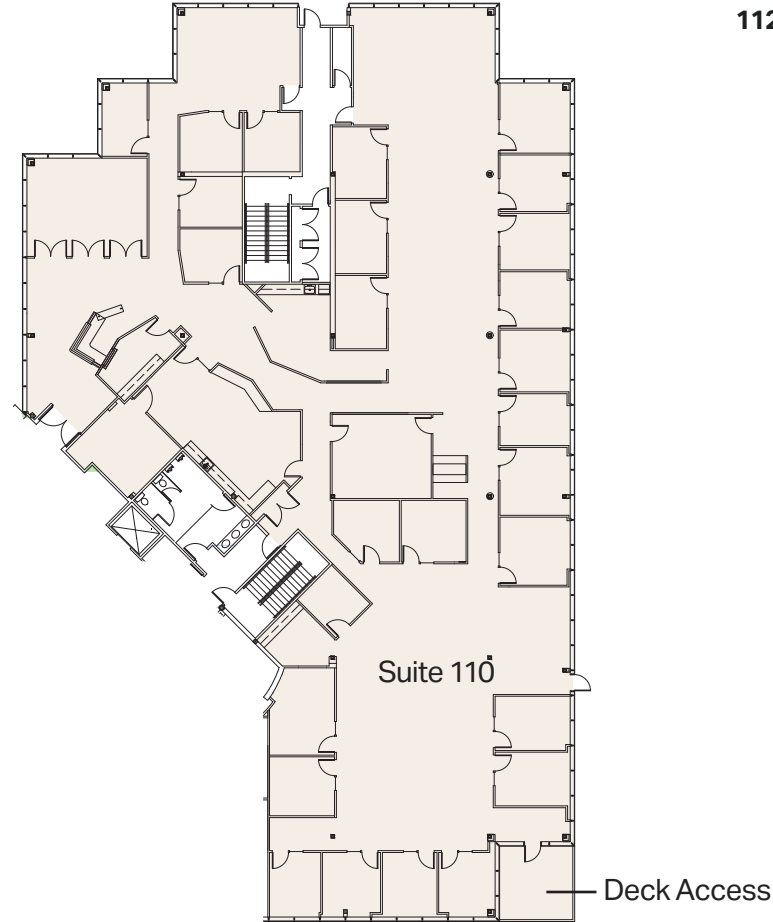

KEY SITE
PLAN

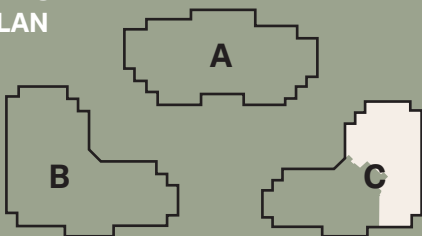


Scott Davis
Executive Vice President
+1 425 941 7573
scott.davis@cbre.com

Tim Owens
Senior Vice President
+1 425 462 6913
tim.owens@cbre.com

Suite 110 | ±14,227 SF
Available Now
Conceptual Plan



KEY SITE
PLAN

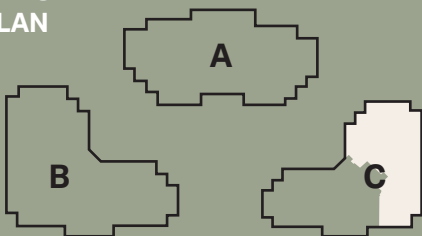


Scott Davis
Executive Vice President
+1 425 941 7573
scott.davis@cbre.com

Tim Owens
Senior Vice President
+1 425 462 6913
tim.owens@cbre.com

Suite 110 A | ±5,752 SF
Conceptual Demised Plan



KEY SITE
PLAN

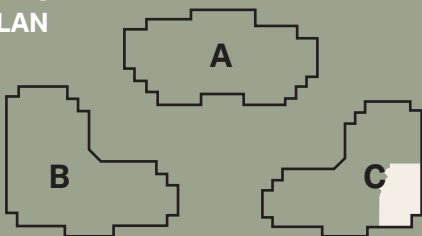

Scott Davis
Executive Vice President
+1 425 941 7573
scott.davis@cbre.com

Tim Owens
Senior Vice President
+1 425 462 6913
tim.owens@cbre.com