


Suite 200 | ±8,527 SF
Divisible
As-Built Plan

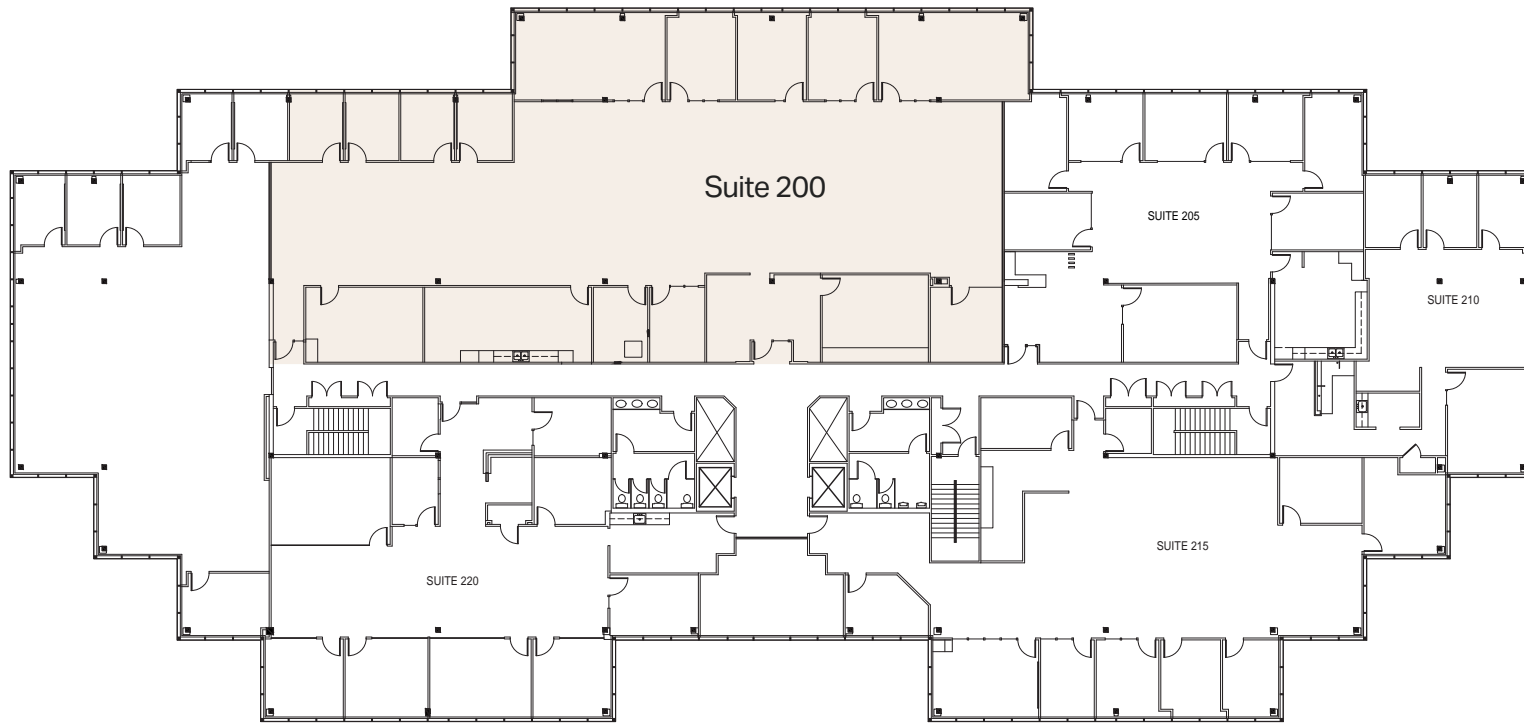

**KEY SITE
PLAN**




Scott Davis
Executive Vice President
+1 425 941 7573
scott.davis@cbre.com

Tim Owens
Senior Vice President
+1 425 462 6913
tim.owens@cbre.com



© 2026 CBRE, Inc. All rights reserved. This information has been obtained from sources believed reliable, but has not been verified for accuracy or completeness. You should conduct a careful, independent investigation of the property and verify all information. Any reliance on this information is solely at your own risk. CBRE and the CBRE logo are service marks of CBRE, Inc. All other marks displayed on this document are the property of their respective owners, and the use of such logos does not imply any affiliation with or endorsement of CBRE. Photos herein are the property of their respective owners. Use of these images without the express written consent of the owner is prohibited. BSO_4.14.26

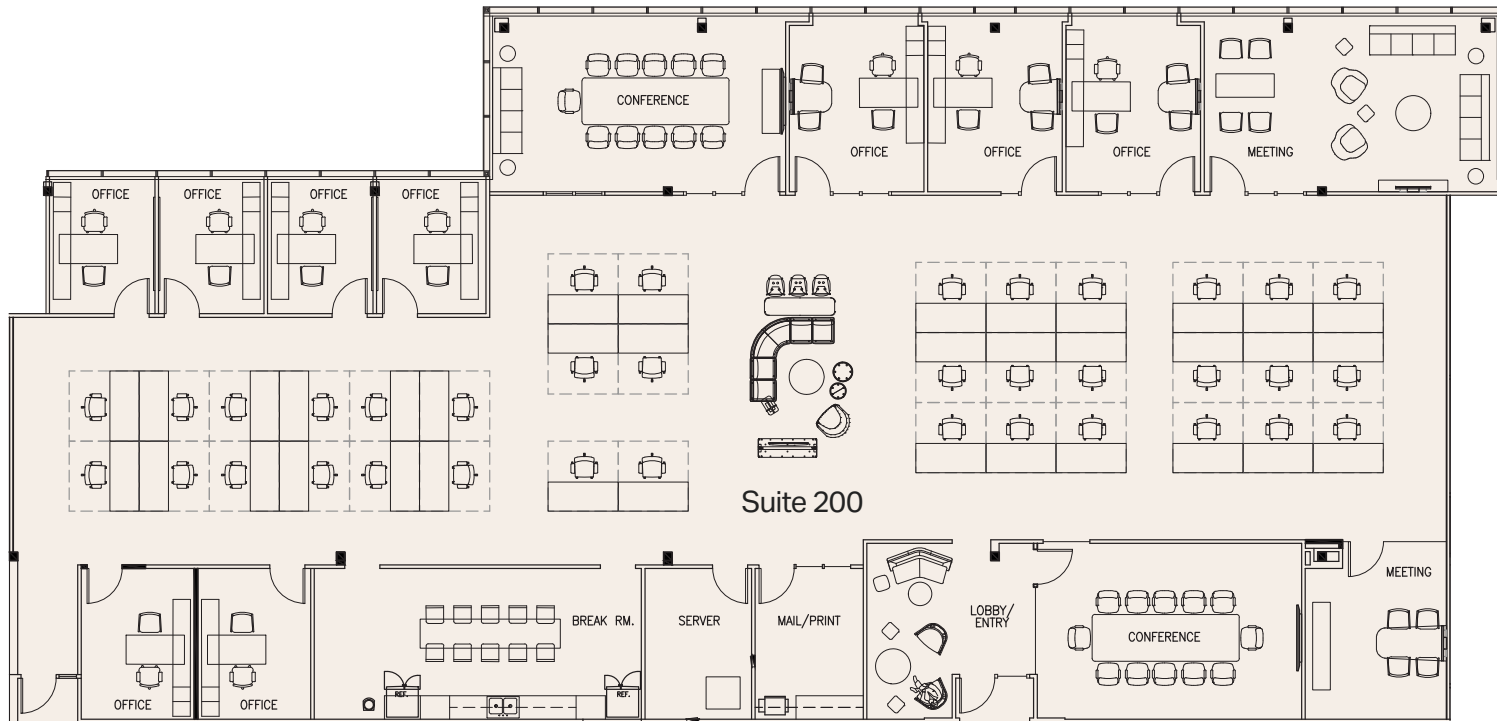

KEY SITE PLAN



Scott Davis
Executive Vice President
+1 425 941 7573
scott.davis@cbre.com

Tim Owens
Senior Vice President
+1 425 462 6913
tim.owens@cbre.com

