


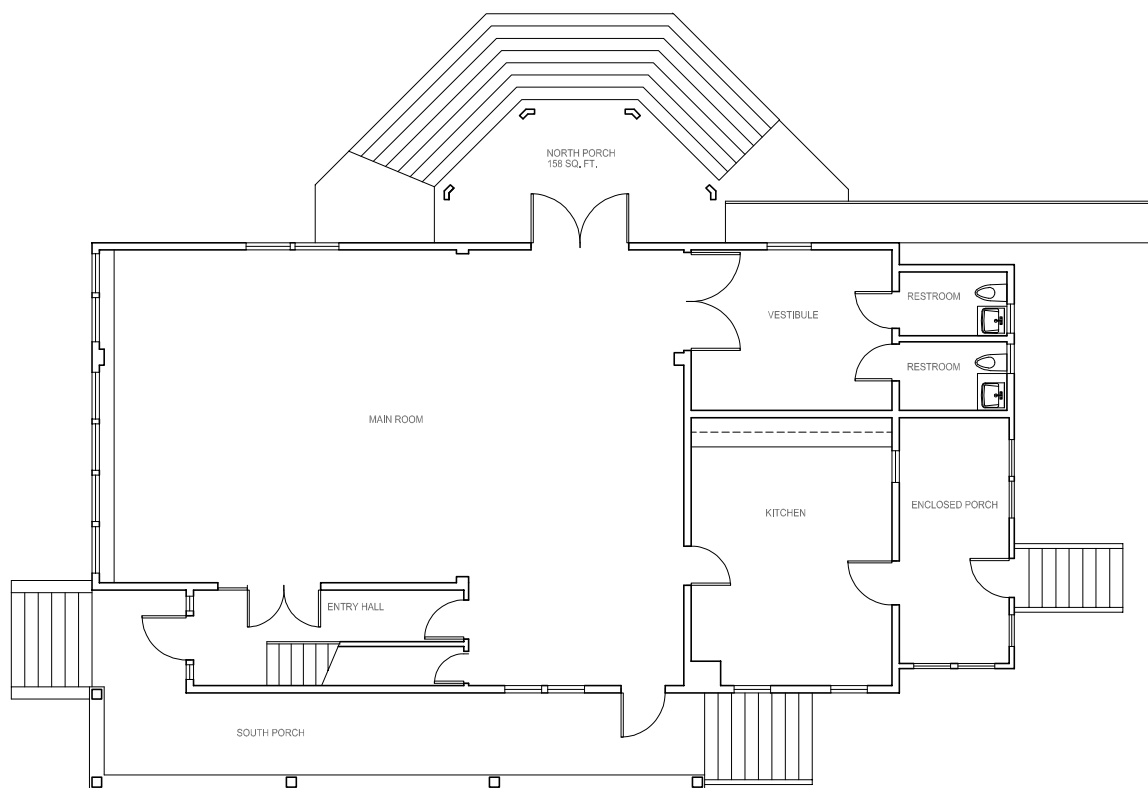

1 MAIN FLOOR PLAN
1/4" = 1' - 0"



..\..\Title Blocks\RAI logo.jpg

105 S. Main Street Suite 323
Seattle, WA 98104
t: 206-624-4222
f: 206-624-4226



THE GARDEN HOUSE

22336 15TH AVE S
SEATTLE, WA 98144

HISTORIC SEATTLE
11117 MINOR AVE
SEATTLE, WA 98101
TEL: (206) 622-6952
FAX: (206) 622-1197
www.historicseattle.org

[illegible]

Design: XX
 Drawn: XX
 Checked: XX
 Project No.

Issuance

AS-BUILT PLANS

Date: 9/28/2022

Drawing Title
MAIN FLOOR
PLAN

Drawing Number

A 102