


**TENANT 1 - 3,535 SQFT**  
**TENANT 2 - 1,293 SQFT**

**1 LEVEL 1 - FLOOR PLAN**  
3/16" = 1'-0"

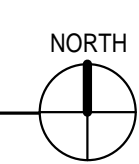

**207 S 2ND AVE**  
SEATTLE, WASH.

**AS-BUILT**

ISSUED: JUNE 7, 2022

REVISION SCHEDULE	
#	DESCRIPTION

FLOOR PLAN - LEVEL 1

PROJECT #: 2021123.00

**A21.2**