


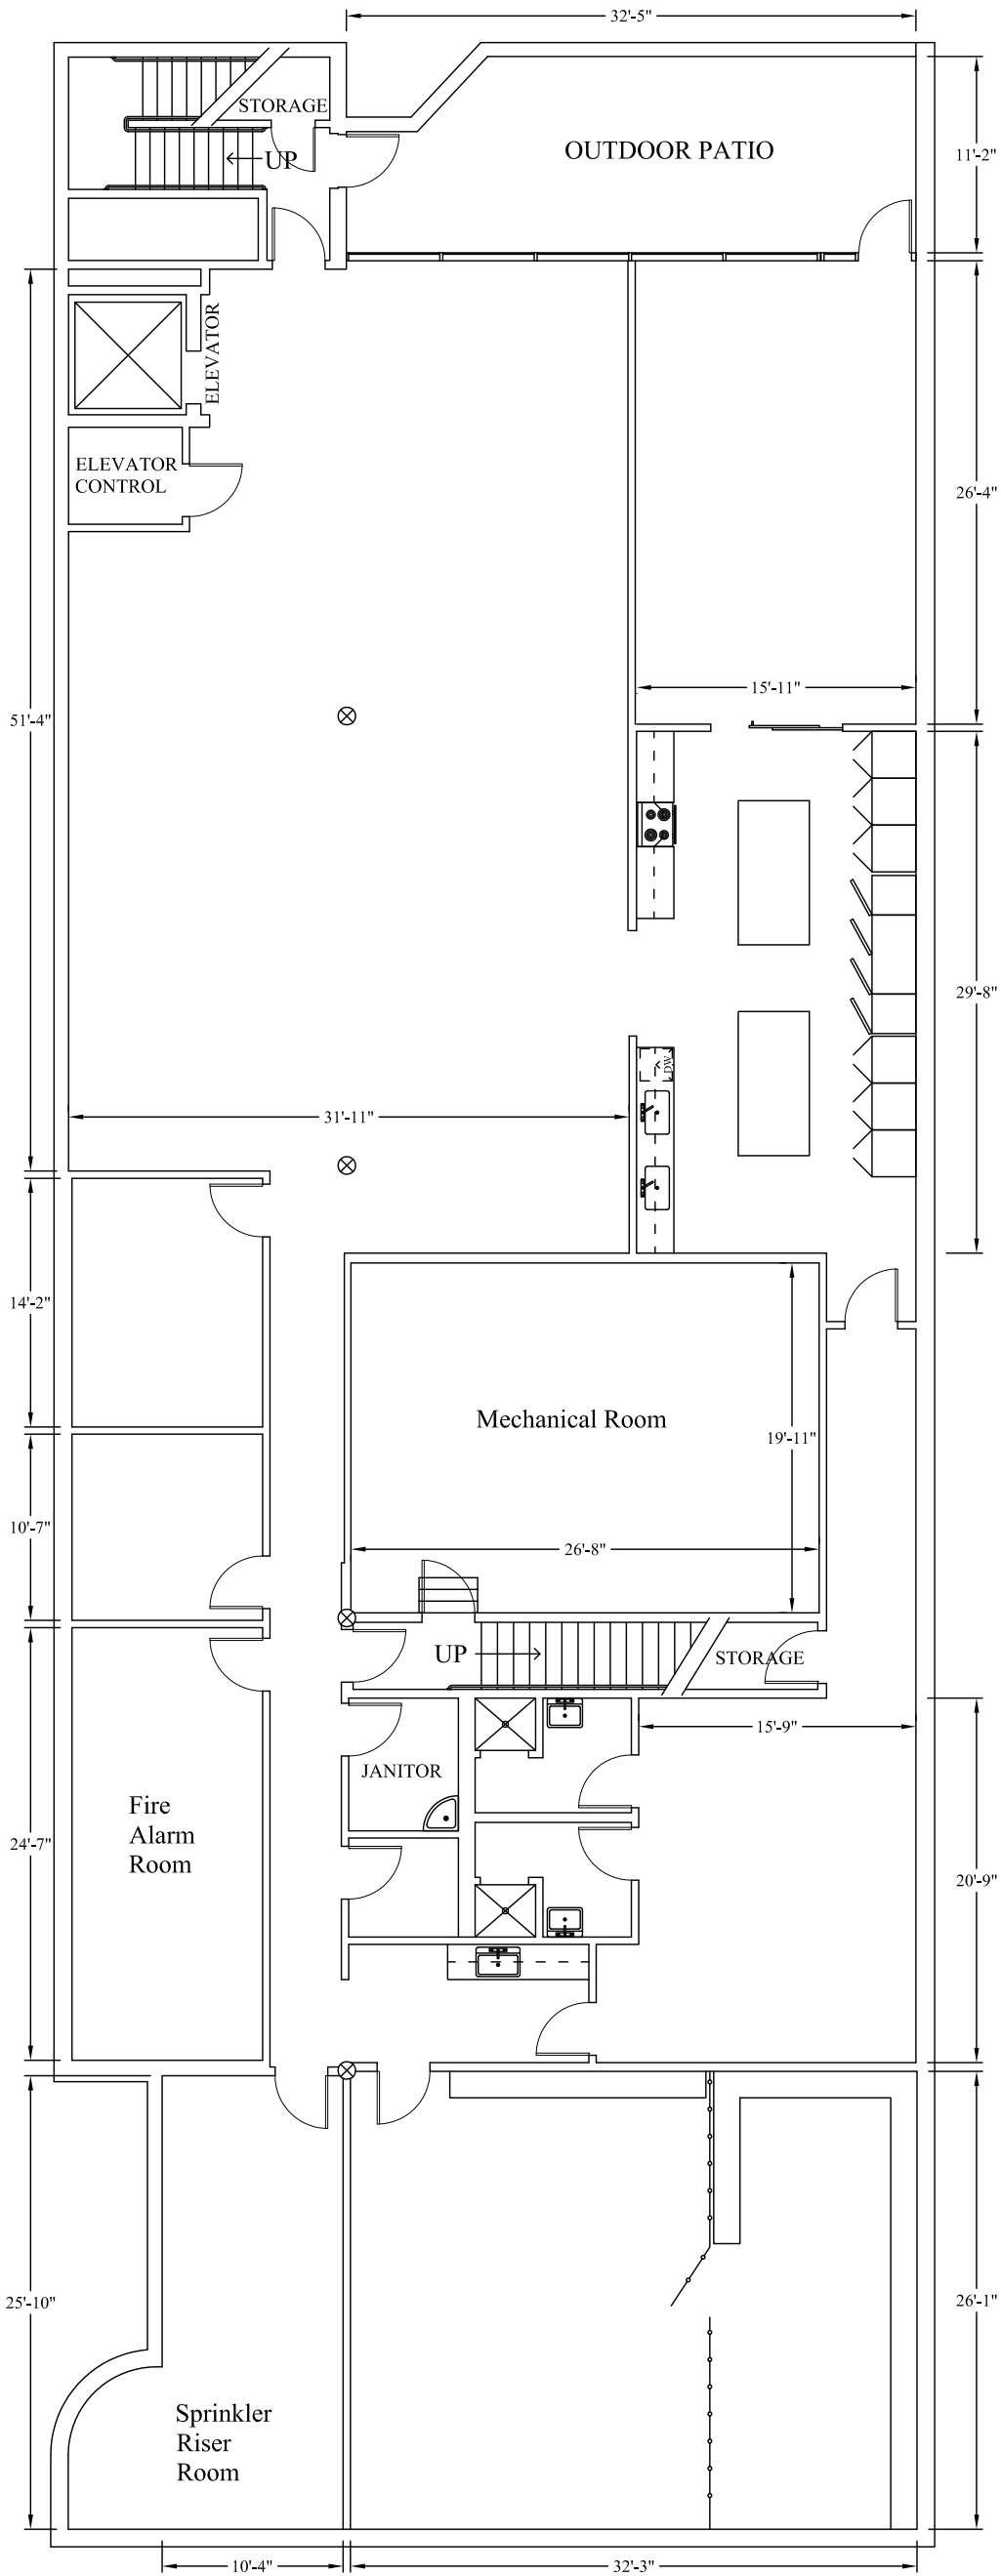


244 W Main - Basement

Scale:  $\frac{3}{16}$ "=1'-0"


Existing

February 29, 2024

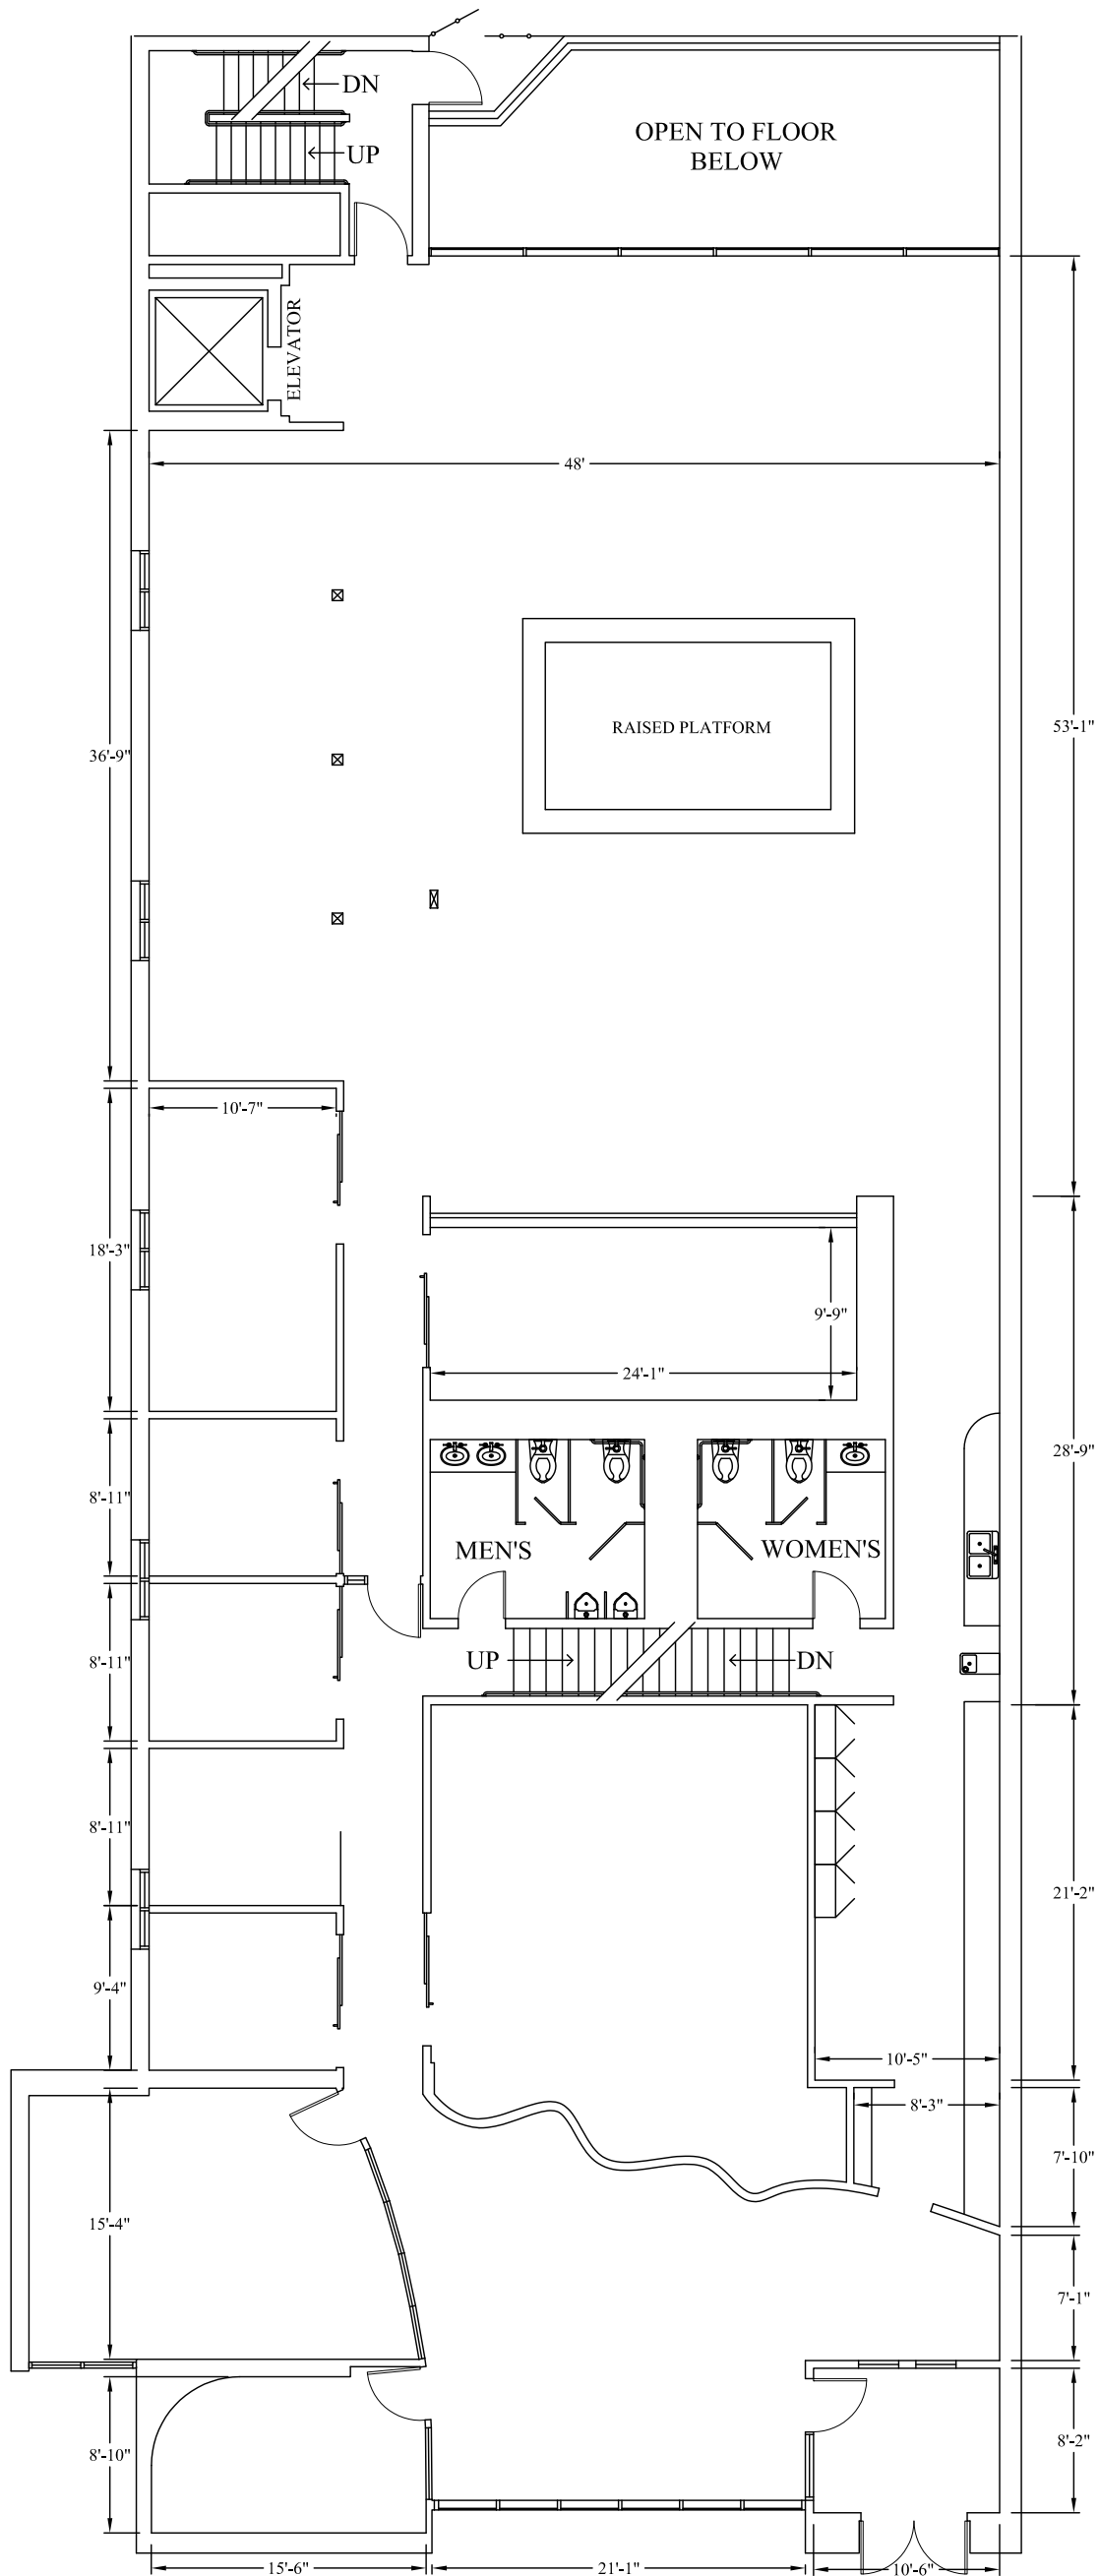

244 W Main - Main Floor  
Scale:  $\frac{3}{16}"=1'-0"$

Existing  
February 29, 2024

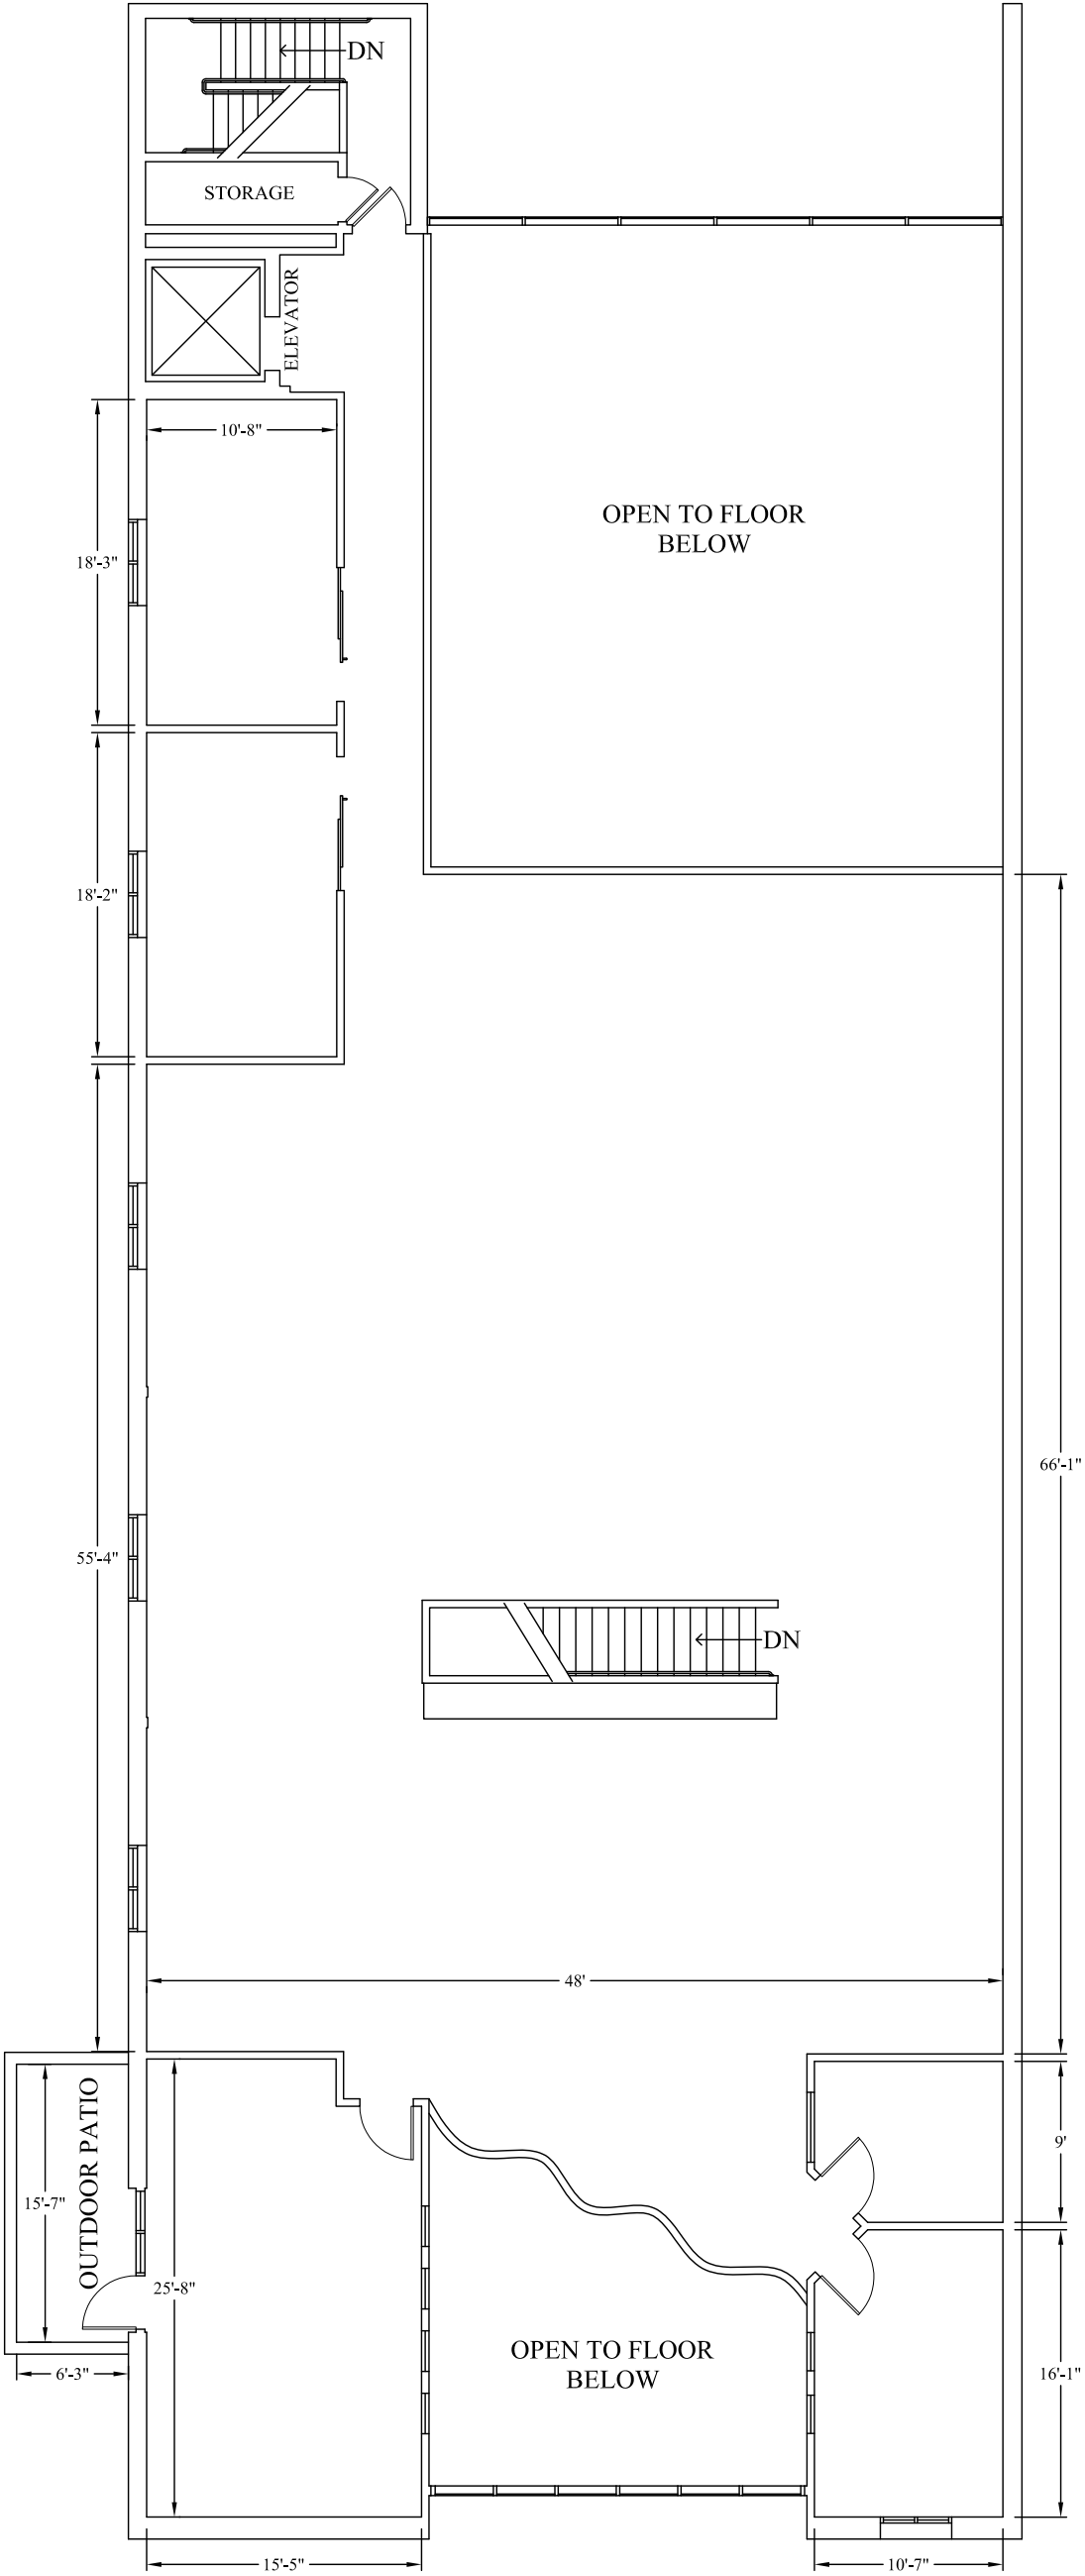

244 W Main - Mezzanine

Scale:  $\frac{3}{16}"=1'-0"$

Existing

February 29, 2024