



NOTES:

- SOLID BLACK LINE INDICATES EXISTING CONST.
- DASHED BLACK LINE INDICATES CONST. TO BE REMOVED
- SOLID RED LINE INDICATES NEW CONST.
- DASHED RED LINE INDICATES WINDOWS TO BE BLOCKED OFF
- ALL DOORS 3'-0" WIDE (UND)

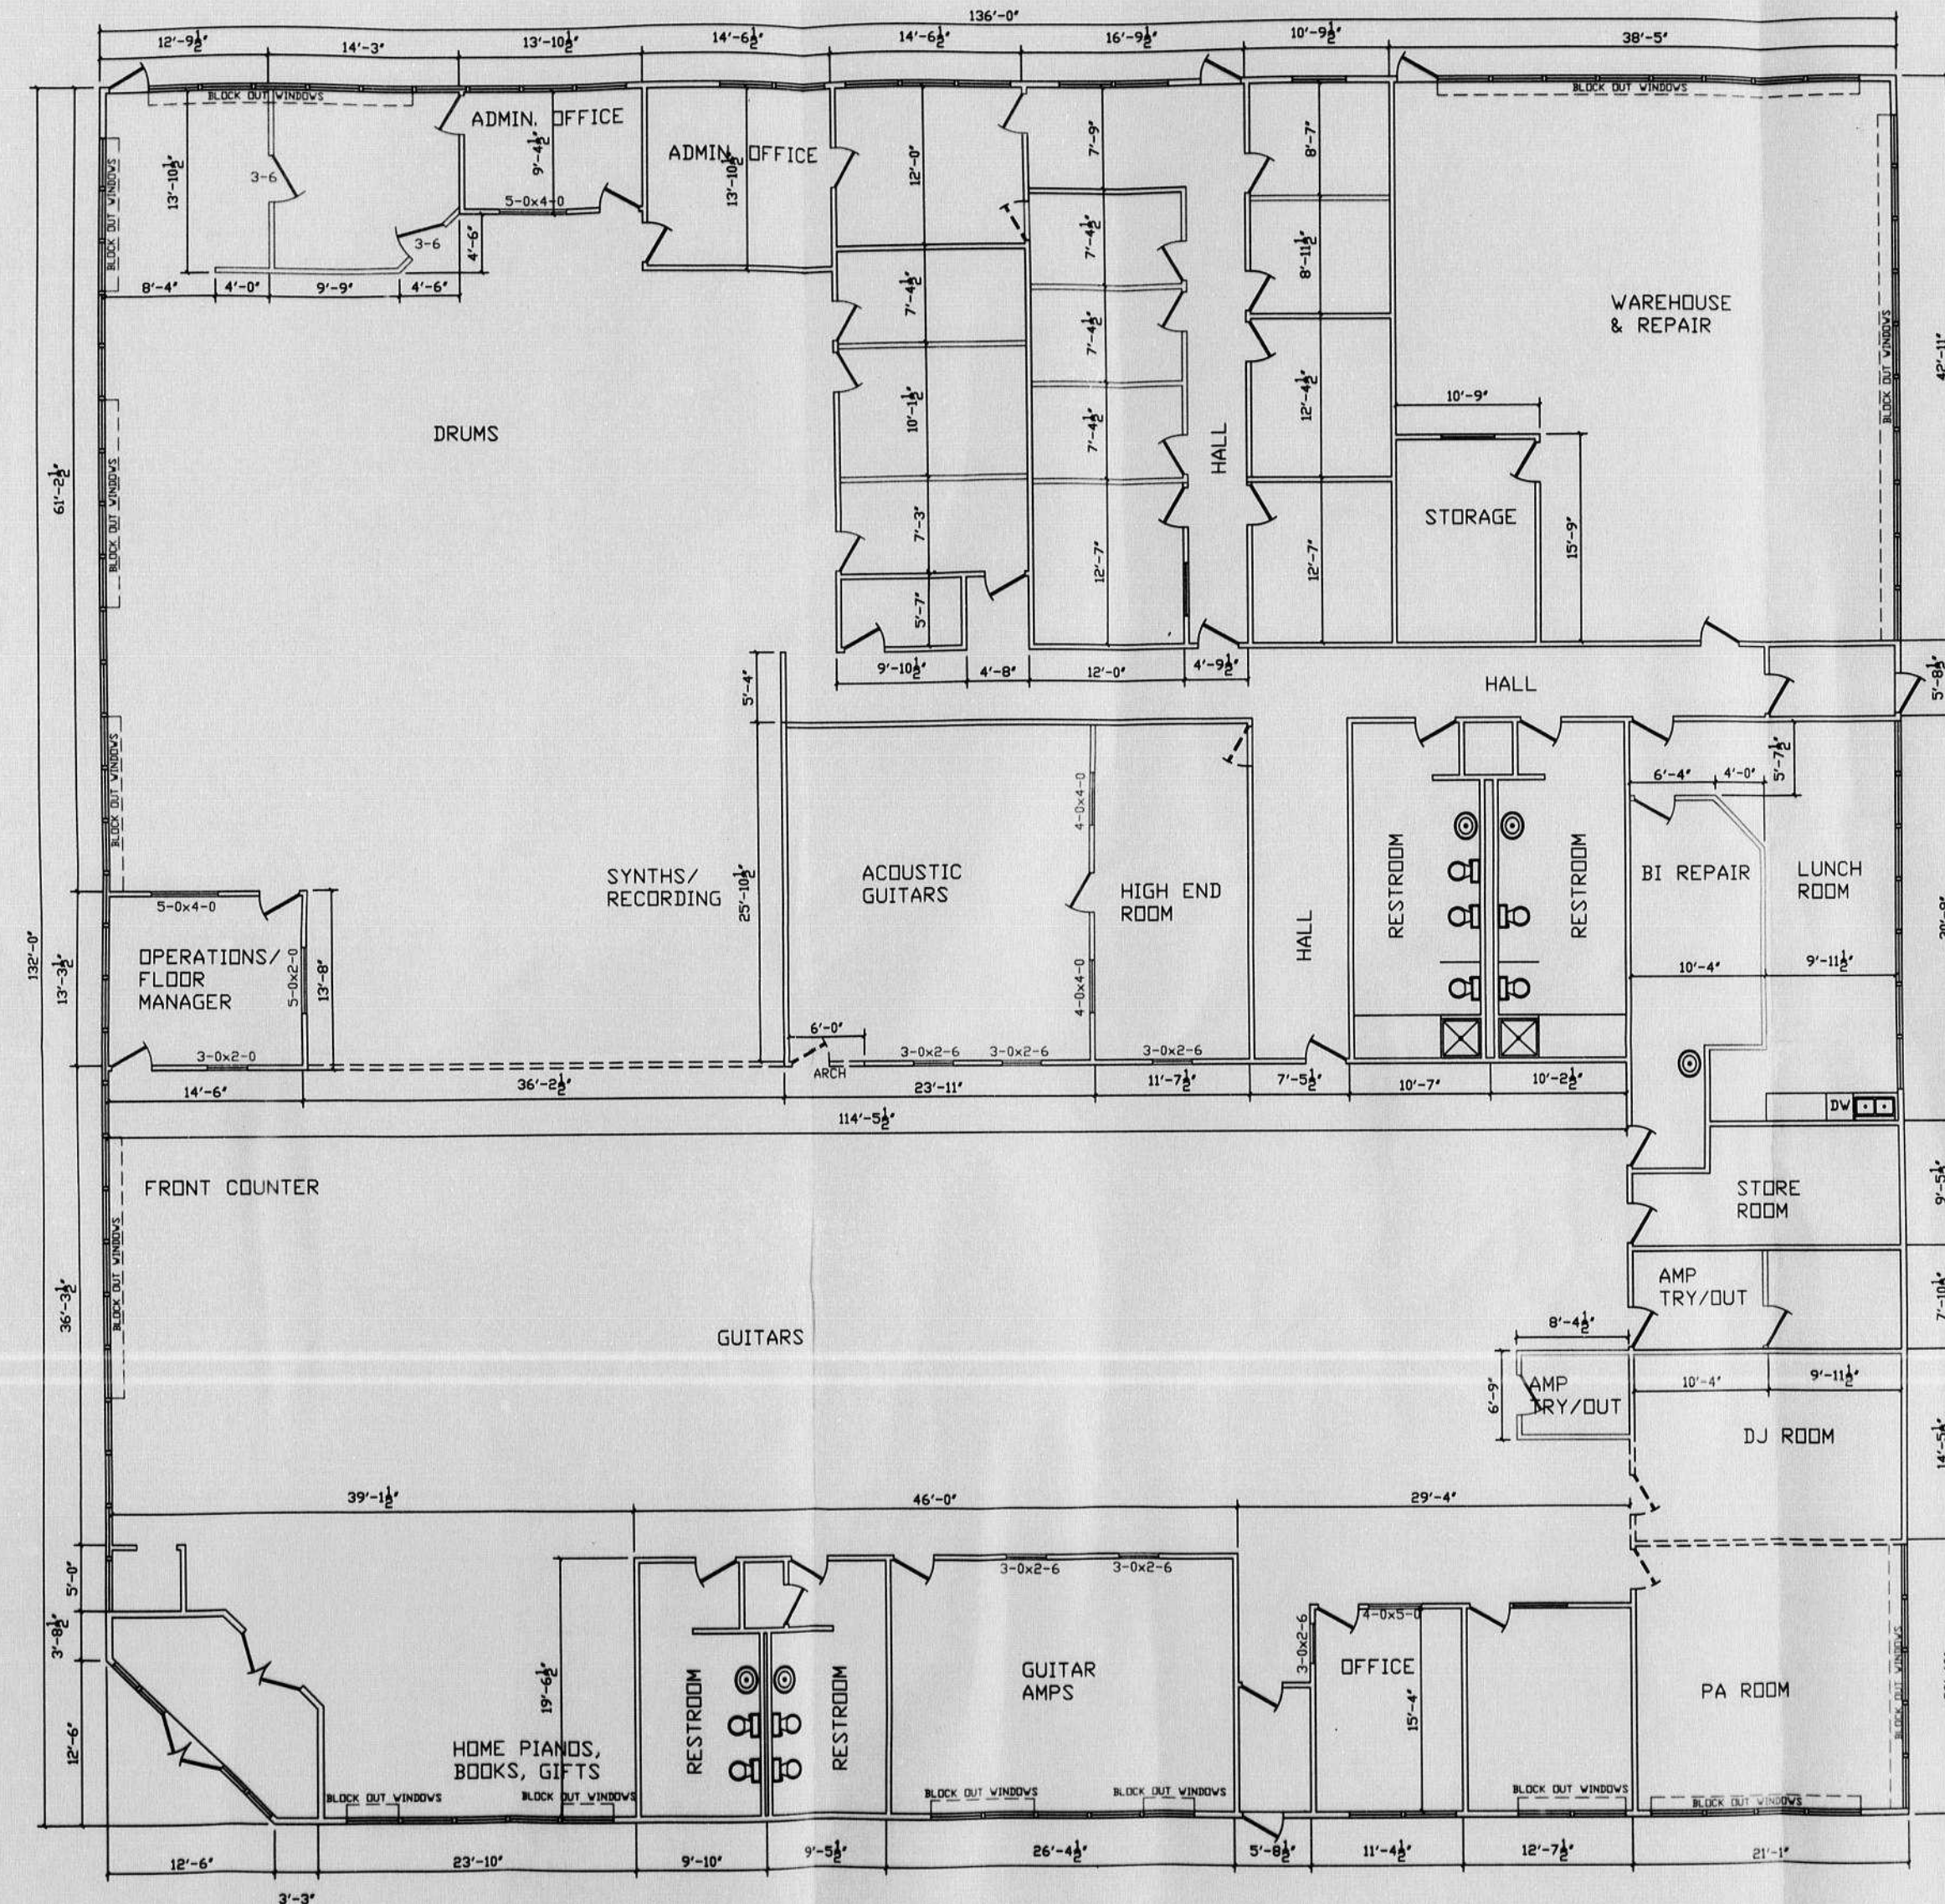

MAIN FLOOR PLAN
SCALE: 1/8" = 1'-0"

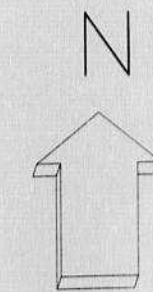

DESIGNED BY:

DRAWN BY:
JC DESIGN
948 NEIL ST. #18
OLYMPIA WA 98516
(360) 790-1705
FAX (360) 570-1890

MUSIC 6000
3738 PACIFIC AVE SE
OLYMPIA WA 98501
(360) 786-6000
XXXXXXXXXX

REVISIONS

FILE COPY

DATE
JOB NO.

SHEET TITLE
JUL 17 2006

SHEET NO.

A1.1

29

00177

001208
MUSIC 6000
PACIFIC AV SE 3738
CR

