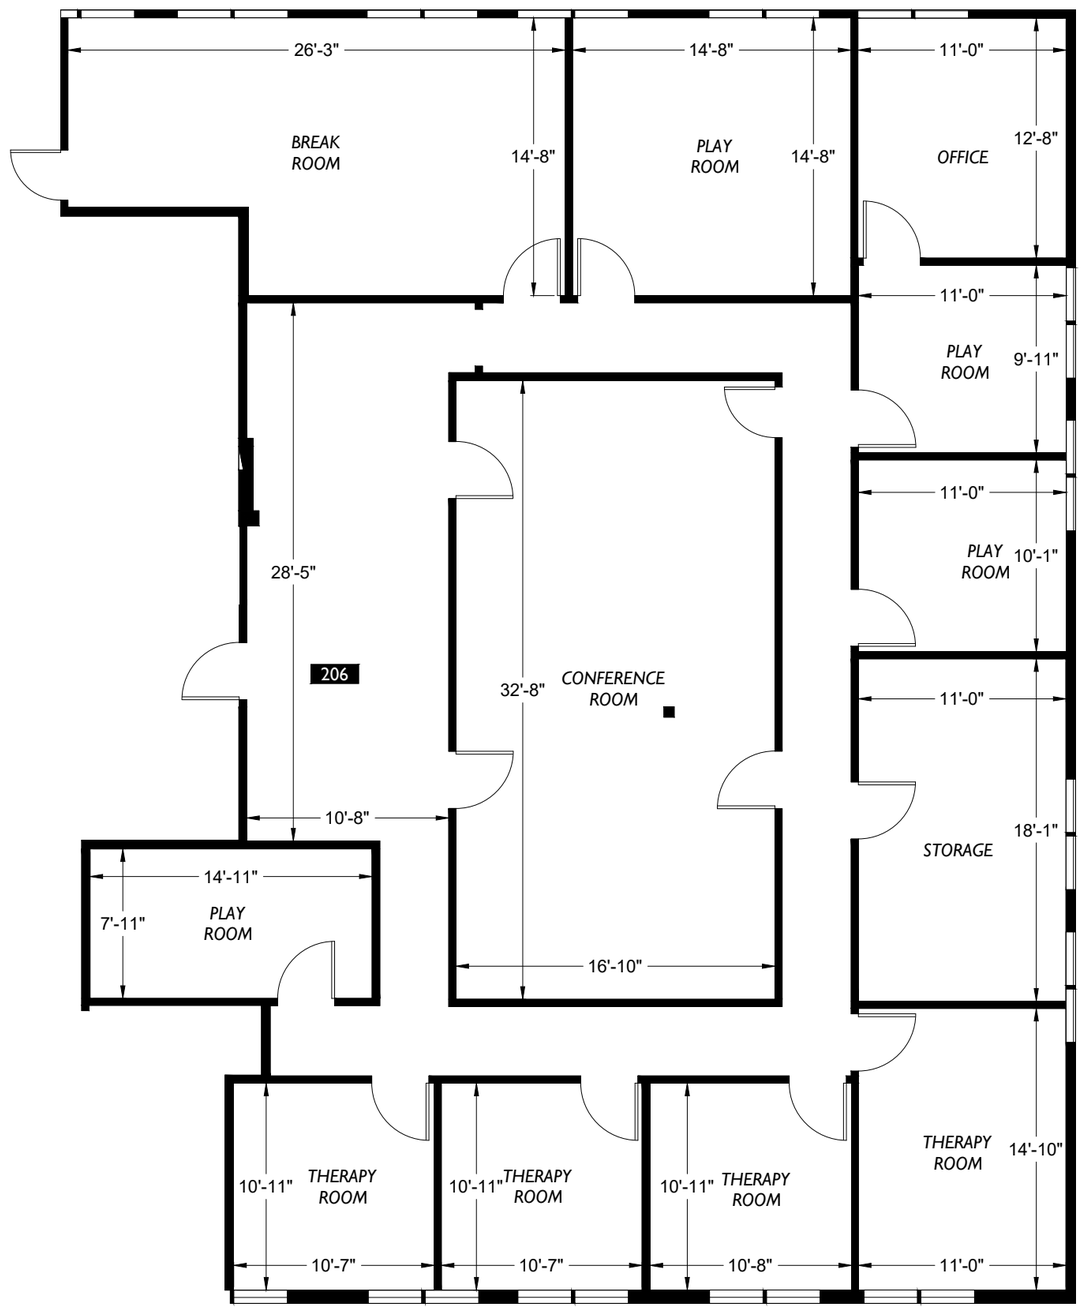

Suite #	Occupant Area	Rentable Area
Suite 206	3,146.23*	3,632.31*

***Area includes a proportional share of Limited Common Area LC1 (57.07 SF).**

0 10 20

Scale: 1/8" = 1'-0"

2-D AS-BUILT FLOOR PLANS

2DFLOORPLANS.COM

371 NW Gilman Blvd.
Suite 140
Issaquah, WA 98027
425-677-7511

This drawing is an instrument of service and is the sole property of the client listed. Any alteration of this drawing without removal of references to 2-D As-Built Floor Plans, Inc. is prohibited.

Drawing scale and dimensions are provided for reference only. Refer to CAD files for exact measurements.

©2010 2-D As-Built Floor Plans, Inc. All Rights Reserved.

Area Analysis performed in accordance with ANSI/BOMA Z65.1 - 2017 Method A Standard.

Project: C22-989

Date Project	Action
May 2020 C20-412	Initial Site Measure.
10/3/2022 C22-989	Provide Suite Plans for Suites 204 and 206 .

Client:
Markoa Commercial Real Estate

Site:
Jade Plaza
8811 South Tacoma Way
Lakewood,WA- 98499

Suite Plan

206

Suite