Interstate 5
Neighboring Commercial Buildings
Parking Lot

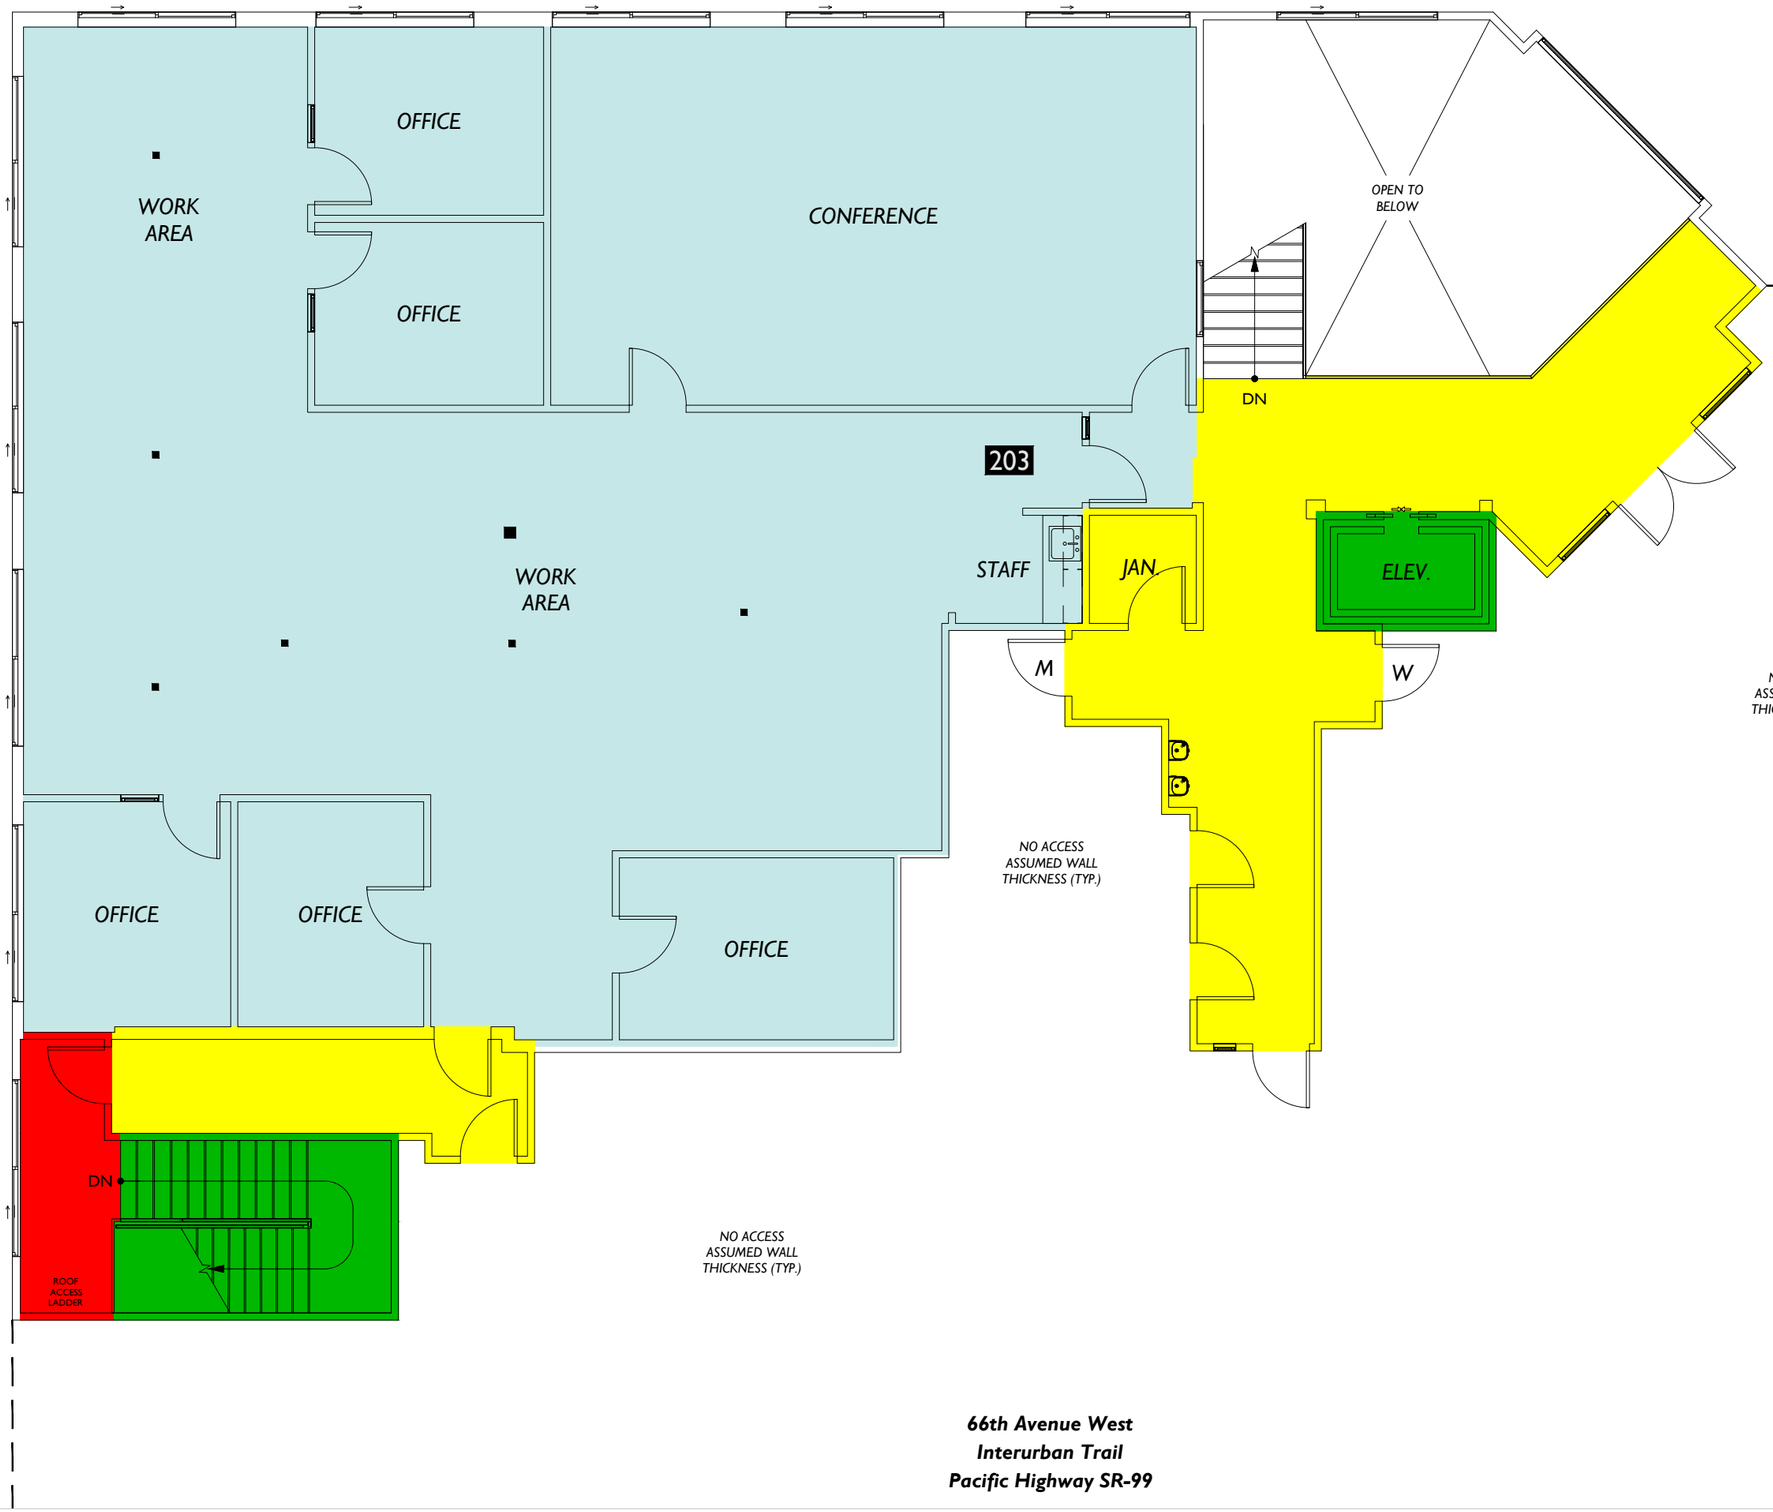

212th Street Southwest
Interurban Trail
Parking Area

Parking Lot
216th Street Southwest
220th Street Southwest

66th Avenue West
Interurban Trail
Pacific Highway SR-99

Suite #	Occupant Area
Suite 203	2,951.21

Floor Service Area	675.00
Building Service Area	76.03
Total Vertical	205.98

0 10 20

Scale: 1/8" = 1'-0"

2-D AS-BUILT FLOOR PLANS

2DFLOORPLANS.COM

371 NW Gilman Blvd.
Suite 140
Issaquah, WA 98027
425-677-7511

This drawing is an instrument of service and is the sole property of the client listed. Any alteration of this drawing without removal of references to 2-D As-Built Floor Plans, Inc. is prohibited.

Drawing scale and dimensions are provided for reference only. Refer to CAD files for exact measurements.

©2010 2-D As-Built Floor Plans, Inc. All Rights Reserved.

GPRS

Area Analysis performed in accordance with ANSI/BOMA Z65.1 - 2024 Method A Standard.

Project: 103892

Date Project	Action
5/18/20206	Initial Building Measure - Suite 203 only
103892PROJ	

Client:
Azose Commercial Properties

Site:
Office Building
6505 216th Street Southwest
Mountlake Terrace, WA 98043

Lease Plan

203

Suite