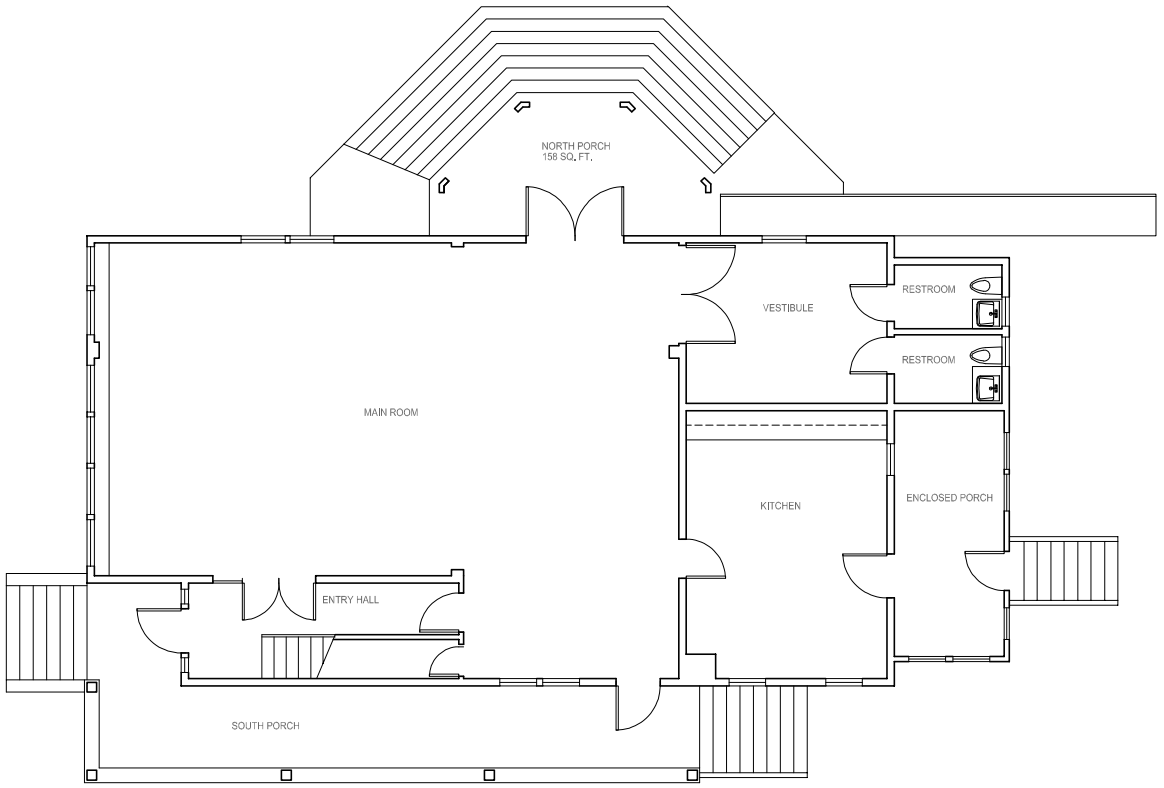

MAIN FLOOR GROSS AREA (INCLUDING PORCHES): 2336 SQ. FT.

1 MAIN FLOOR PLAN
1/4" = 1' - 0"

..\..\Title Blocks\RAI logo.jpg

105 S. Main Street Suite 323
Seattle, WA 98104
t: 206-624-4222
f: 206-624-4226

6250 REGISTERED ARCHITECT
Alex E. Rolluda
STATE OF WASHINGTON

THE GARDEN HOUSE

2336 15TH AVE S.
SEATTLE, WA 98144

OWNER:
HISTORIC SEATTLE
1117 MINOR AVE
SEATTLE, WA 98101
TEL: (206) 622-6952
FAX: (206) 622-1197
www.historicseattle.org

REVISION	DATE

Design: XX
Drawn: XX
Checked: XX
Project No.

Issuance
AS-BUILT PLANS
Date: 9/28/2022

Drawing Title
MAIN FLOOR PLAN

Drawing Number
A 102

COPYRIGHT © 2018 ROLLUDA ARCHITECTS INC

A101-FLOR_PLAN.DWG
9/29/2022 2:28 PM